


Section 10 Township 14 Range 14W

Well No. 7 S. Boxberger

Company H.H. Blair

Hall-Gurney  
NORTH

15

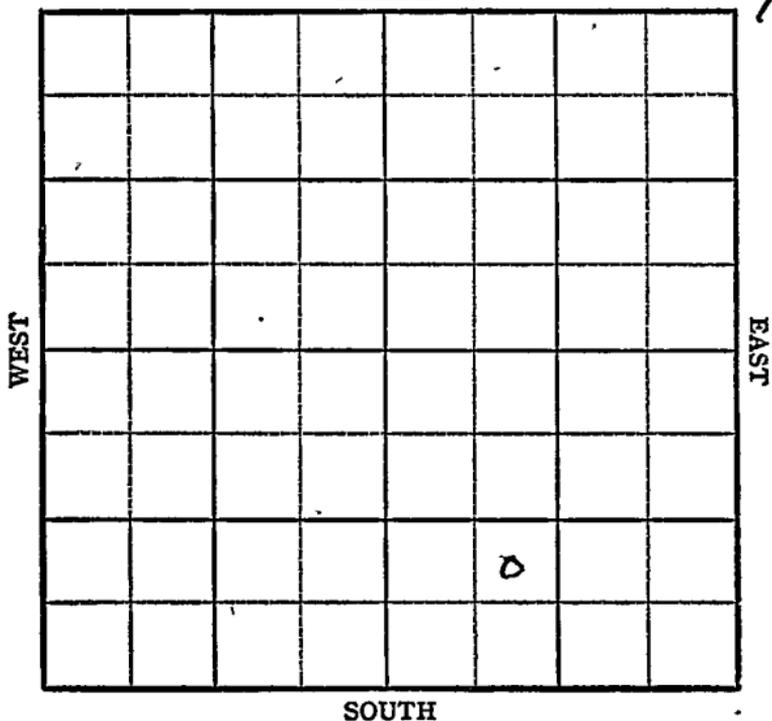

Sec. 10 Twp. 14 R. 14W

Well No. #7 S. Boxberger Farm

H. H. Blair Company


Hall-Gurney

\_\_\_\_\_ Ft. from N. Line  
990'

\_\_\_\_\_ Ft. from S. Line

\_\_\_\_\_ Ft. from E. Line

990' \_\_\_\_\_ Ft. from W. Line

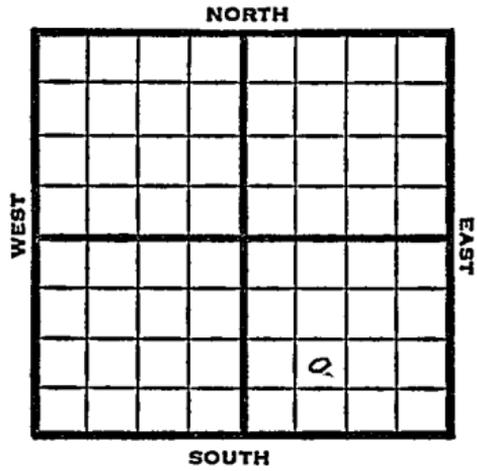

NE SW SE

1948 Elev 1842' REPORT

12/15 Location  
12/22 " "  
12/29 Spuds --  
1/5 102 @ 160'  
Drlg. 2540'

1/12 Varkio 2390 Topeka 2630  
Lansing 2991 TD 2993 SO  
7" @ 2992.

1/19 " "  
1/26 " "  
2/2 " "  
2/9 TD 3049'  
5000 acid

2/16 " "  
2/23 TD 3049'  
Lans. 2991'  
7" @ 2992 '  
5000 acid  
Pump 150 Oil -/ 65 W Pot  
40<sup>9</sup> Gr.  
Com p  
**COMPLETED**

Map No. \_\_\_\_\_ Sec. 10 Twp. 14 R. 14W

Well No. 7 S. Boxberger

H. H. Blair Company

FIRST REPORT Contractor

NE SW SE

SECTION PLAT


\_\_\_\_\_ Ft. from N. Line

990 Ft. from S. Line

\_\_\_\_\_ Ft. from E. Line

990 Ft. from W. Line

Russell County

Location x

Rig up \_\_\_\_\_

Drilling and Remarks:

RECORD

Cased \_\_\_\_\_ in., \_\_\_\_\_ ft.

Sand \_\_\_\_\_

Gas \_\_\_\_\_

Oil \_\_\_\_\_

Total Depth \_\_\_\_\_

PRODUCTION

1st 24 hrs. Nat. \_\_\_\_\_

1st 24 hrs. after shot \_\_\_\_\_

Gas \_\_\_\_\_ Cu. Ft.

Dry Hole \_\_\_\_\_

Abandoned \_\_\_\_\_

Date

DEC 15 1948 19

S. J. LEWIS Scout

