


KANSAS

Section 4 Township 29 Range 6-E

Well No. #6 Semisch

Company Dunn & Strait
Miscellaneous

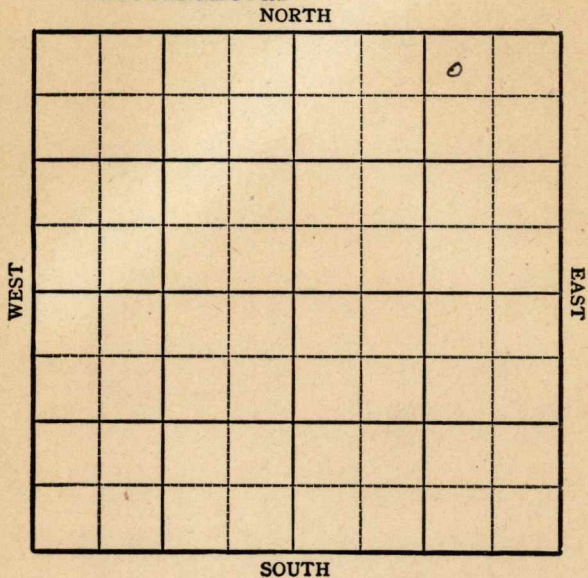

Butler
29

KANSAS
6E

Sec. 4 Twp. _____ R. _____

Well No. #6 Semisch Farm _____

Dunn & Strait

Company


Miscellaneous (Dunn & Strait Contr.)

330' Ft. from N. Line

_____ Ft. from S. Line

990' Ft. from E. Line

_____ Ft. from W. Line

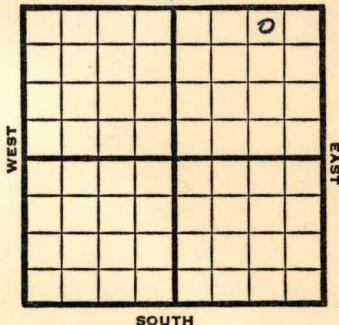

NW NE NE

SOUTH

1949

Elev. 1407' REPORT

11/30

8" @ 140'
Drlg. 870'

12/7

KC 1950'
Drlg 2560'

12/14

Miss 2821'
TD 2835'

ABANDONED

Map No. _____ Sec. 4 Twp. 29 R. 6E

Well No. 6 Semisch

Dunn & Strait Company

Dunn & Strait Contractor

NW NE NE

FIRST REPORT
SECTION PLAT

330 Ft. from N. Line

_____ Ft. from S. Line

990 Ft. from E. Line

_____ Ft. from W. Line

			b

Butler County

RECORD

Location _____

Cased _____ in., _____ ft.

Rig up _____

Sand _____

Drilling and Remarks:

Gas _____

Oil _____

8" @ 140

Total Depth _____

drlg. 870

PRODUCTION

1st 24 hrs. Nat. _____

1st 24 hrs. after shot _____

Gas _____ Cu. Ft.

Dry Hole _____

Abandoned _____

Date

NOV 30 1949

S. J. LEWIS

Scout

Map No. _____ Sec. 4 Twp. 29 R. 6E

Well No. 6 Semisch

Dunn & Strait Company

ABANDONED

Contractor

NW NE NE

E. 1407

SECTION PLAT

330 Ft. from N. Line

_____ Ft. from S. Line

990 Ft. from E. Line

_____ Ft. from W. Line

			0

Butler County

RECORD

Location _____

Cased _____ in. _____ ft.

Rig up _____

Sand _____

Drilling and Remarks:

Gas _____

Oil _____

Total Depth 2835

PRODUCTION

1st 24 hrs. Nat. _____

1st 24 hrs. after shot _____

Gas _____ Cu. Ft.

Dry Hole _____

Abandoned _____

Misc 2821

Date

DEC 14 1949

19

S. J. LEWIS

Scout