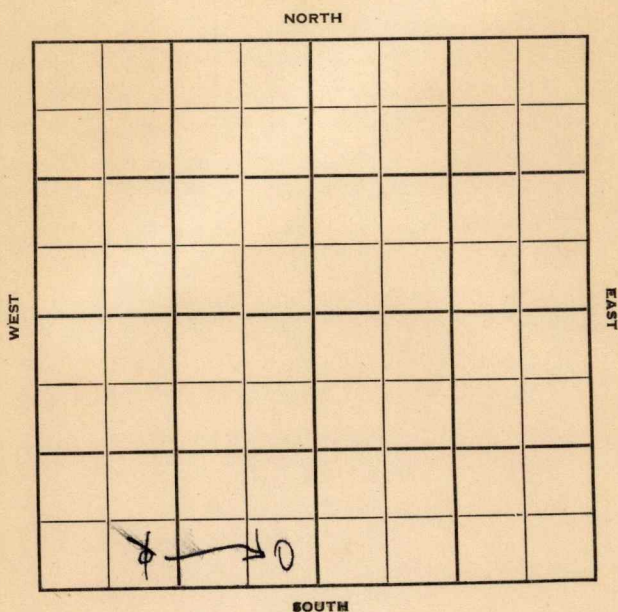


Section 4 Township 29 Range 6-EWell No. #7 SemeichCompany Dunn & Strait

KANSAS

Butler

Sec. 4 Twp. 29 R. 6E ✓

Well No. #7 Semeich Farm

Dunn & Strait Company

Contractor

Ft. from N. Line

330'

Ft. from S. Line


330'

Ft. from E. Line

~~990'~~

Ft. from W. Line

SE ~~SW~~ SW Twin
SE

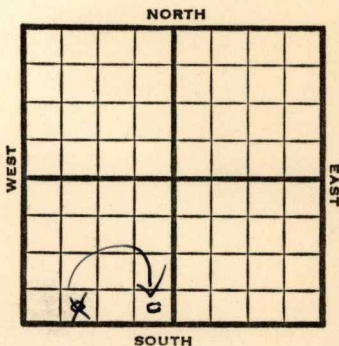

1950

Elev 1417

REPORT

10/25

Location

12/13

Spud 10-27-50

8 5/8" @ 100

Peru 2504

B Peru 2521

5 1/2" @ 2810

TD 2823

Comp 40 bopd

Completed

COMPLETED

County

Butler

State

Kansas

Sec.

4

(Blk.)
(Twp.)

29

(Sur.)
(Rge.)

6E

Map No.

Operator

Dunn & Strait

Well No.

7

Farm

Semeich

Elev.

Location

SE SW SW

twin

330

Ft. From

S

Line

SW

990

Ft. From

W

Line

Quarter

1st. Report

OCT 25 1950

Completion

Remarks

Spudding Date

Drig. Data

Location

J. E. TYRA

Kansas

Map No. _____ Sec. 4 Twp. 29 R. 6EWell No. 7 SemeichDunn & Strait

Company

CORRECTION

Contractor

SE SE SW

SECTION PLAT

_____ Ft. from N. Line

330

_____ Ft. from S. Line

330

_____ Ft. from E. Line

_____ Ft. from W. Line

Butler County

Location _____

Rig up _____

Drilling and Remarks:

Reported

SE SW SW

RECORD

Cased _____ in., _____ ft.

Sand _____

Gas _____

Oil _____

Total Depth _____

PRODUCTION

1st 24 hrs. Nat. _____

1st 24 hrs. after shot _____

Gas _____ Cu. Ft.


Dry Hole _____

Abandoned _____

Date

NOV 1 1950 19J. E. TYRA

Scout

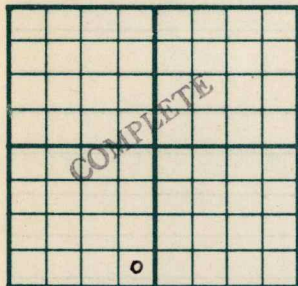County Butler State KansasSec. 4 (Blk.
Twp.) 29 (Sur.
Rge.) 6E Map No.Operator Dunn & StraitWell No. 7 Farm SemeichElev. 1417 Location SE SE SW330 Ft. From S Line SW330 Ft. From E Line Quarter1st. ReportCompletion DEC 13 1950RemarksSpudding Date 10-27-50Drlg. Data Oil well TD 28238 5/8" @ 100 Peru 2504 B peru 25215 1/2" @ 2810 TD 2823 Comp. 40 bopd

J. E. TYRA