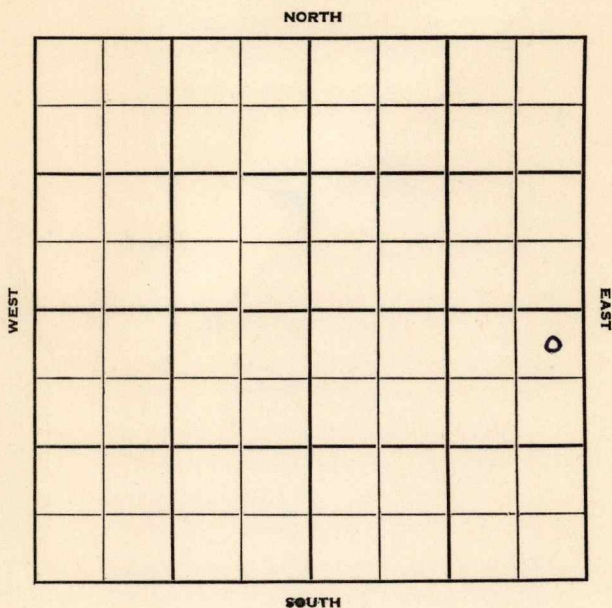


Section h Township 29 Range 6 EWell No. # 12 SemischCompany Dunn & Strait

Butler

KANSAS

Sec. 4 Twp. 29 R. 6E

Well No. #12 Semisch Farm

Dunn & Strait Company

Dunn & Strait - Contr. Contractor

Semisch Pool


430' Ft. from N. Line

Ft. from S. Line

330' Ft. from E. Line

Ft. from W. Line

NE NE SE

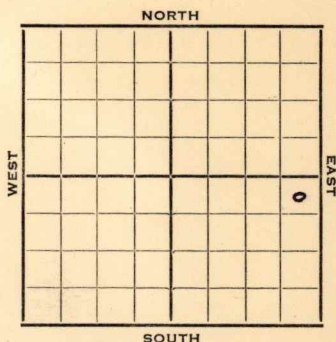

1952

Elev. 1413' REPORT

3/19

Spud 3-14-52

8" @ 98

Drlg. 1257'

4/16

Spud 3-14-52

Oil Well TD 2818

8" @ 98

Bart 2780

5" @ 2780

TD 2818

Hydra Comp F/35 Bopd

COMPLETED

County Butler State KansasSec. 4 (Blk. Twp.) 29 (Sur. Rge.) 6E Map No.Operator Dunn & StraitWell No. 12 Farm SemischElev. 1413 Location NE NE SE

COMPLETE

0

430 Ft. From N Line SE330 Ft. From E Line Quarter

1st. Report

Completion APR 16 1952Remarks Semisch PoolDunn & Strait - Contr.Spudding Date 3-14-52Drlg. Data Oil well TD 28188" @ 98 Bart. 2780 5" @ 2780TD 2818 Hydro. Comp. F/ 35 bopd

J. G. McGEHEE

County **Butler** State **Kansas**

Sec. **4** (Blk. **29** (Sur. **6E** Map No.

Operator Dunn & Strait

Well No. **12** Farm **Semisch**

[illegible]

0

430 Ft. From N Line SE

330 Ft. From E Line Quarter

1st. Report MAR 19 1952

Completion

Remarks

Dunn & Strait - Contr.

Spudding Date **3-14-52**

Drlg. Data Semisch Pool

8" @ 98 drlg. 1257