


Section 10 Township - 14 Range 11W

Well No. #12 Sam Bowberger

Company Texas Company

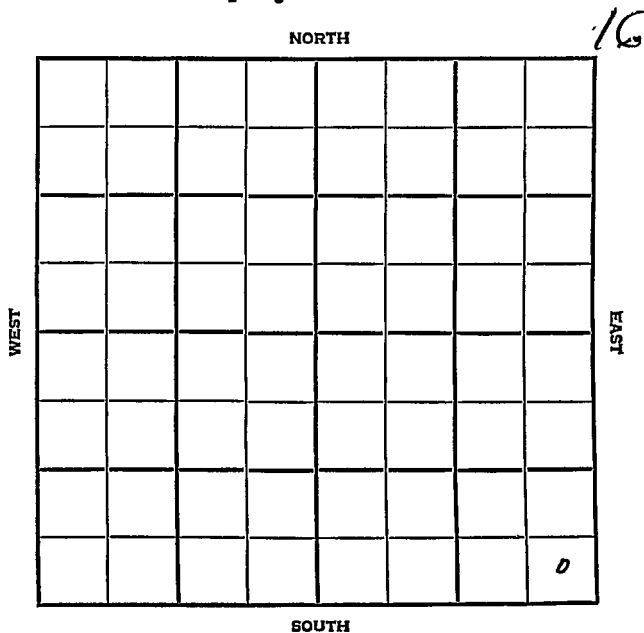

Russell

KANSAS


SEC	TWP	R
10	14	14 W

WELL NO # 12 Sam Boxberger FARM

COMPANY Texas Company

CONTRACTOR Powell  
Hall-Gurney

\_\_\_\_\_ Ft. from N. Line  
 \_\_\_\_\_ Ft. from S. Line  
 \_\_\_\_\_ Ft. from E Line  
 \_\_\_\_\_ Ft. from W. Line

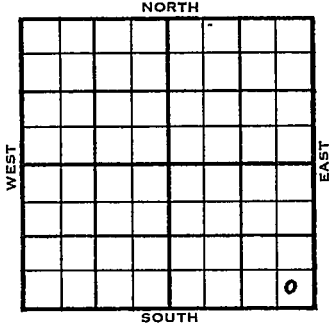

SE SE SE

1955	ELEVATION	REPORT
	1854'	

5/26

Spud 5-6-55  
 10" @ 835  
 7" @ 3263  
 Tops: Topeka 2708', Heebner Sh 2937'  
 Lansing 2996', Regan 3262'  
 TD 3264'  
 CO to 3264' S/9 BOPH 3 hr.  
 147 BOPD Comp.

FIRST REPORT  
 ↓  
 COMPLETED

# FIRST REPORT COMPLETED

FORM 513 REV SUNRAY

County Russell Elev. 1854  
 Sec. 10 Twp. 14 Rge. 14W  
 Company Texas Company  
 Farm Name Sam Boxberger No. 12

TOPS	DEPTH	DATUM
Cim. Anhydrite		
Ft. Riley		
Howard		
Topeka	2708	854
Heebner Sh.	2937	1083
Toronto Ls.		
Brown Lime		
Lansing	2996	1142
Kans. City		
B. K. C.		
Congl. <u>Regan</u>	3262	1408
Miss		
Kinderhook		
Misener		
Hunton		
Sylv. Maquo		
Viola		
Simpson		
Smp.		
Gorham		
Arbuckle		
Basal Sand		
Pre. Cam.		
T. D.	3264	

Loc. in Section SE SE SE

Drlg. Contr. Powell

Pool Hall-Gurney


Date Comm. MAY 25 '55

Spud 5-6-55 10" @ 835 7" @ 3263

CO to 3264 S/ 9 boph' '3'hr.

147 bopd Comp.