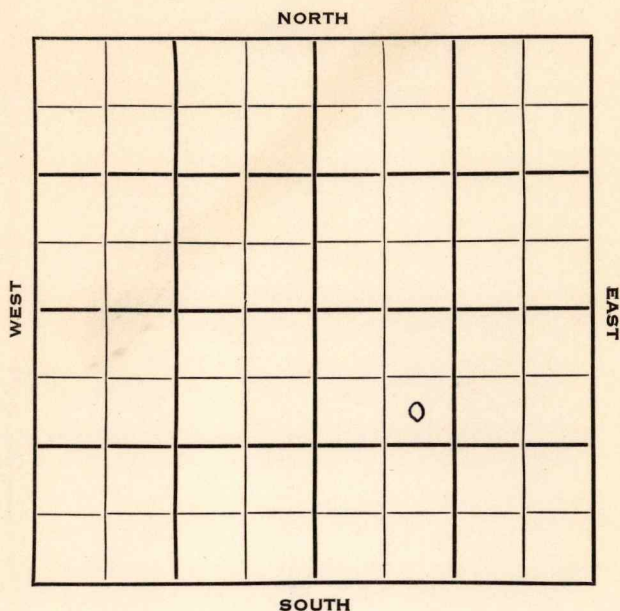


Section 4 Township 29 Range 6EWell No. 18 SemischCompany Dunn & Strait

Butler

KANSAS


Sec. 4 Twp. 29 R. 6EWell No. #18 Semisch FarmDunn & Strait CompanyDunn & Strait ContractorSemisch Pool990 Ft. from N. Line

Ft. from S. Line

Ft. from E. Line

990 Ft. from W. Line

SE NW SE

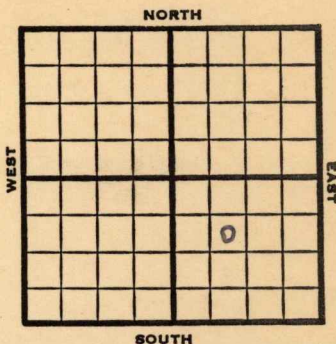

1953

Elev. 1411'

REPORT

4/8

S pud 4-4-53

8" @ 75

Drlg. 690'

4/29

S pud 4-4-53

Oil well TD 2811' 8" @ 75

~~Part~~ 2773 Miss 2810

TD 2780 5" @ 2774 DD 2811

Comp. 25 BOPD

COMPLETED

County Butler State KansasSec. 4 (Blk.) 29 (Sur.) 6E Map No.Operator Dunn & StraitWell No. 18 Farm SemischElev. Location SE NW SE

FIRST REPORT

990 Ft. From N Line SE990 Ft. From W Line Quarter1st. Report APR 8 1953

Completion

Remarks

Dunn & Strait - Contr.Spudding Date 4-4-53Drlg. Data Semisch Pool8" @ 75 drlg. 690

County Butler State Kansas

Sec. 4 (Blk. Twp.) 29 (Sur. Rge.) 6 E Map No.

Operator Dunn & Strait

Well No. 18 Farm Semisch

Elev.	1411	Location	SE NW SE
-------	------	----------	----------


990 Ft. From N Line SE

990 Ft. From W Line Quarter

1st. Report

Completion APR 29 1953

Remarks Semisch Pool

Dunn & Strait - Contr.

Spudding Date 4-4-53

Drlg. Data Oil well TD 2811

8" @ 75 Bart. 2773 Miss. 2810

TD 2780 5" @ 2774 DD 2811

Comp. 25 bopd

J. G. McGEHEE