

Sec. 5 Twp. 29 R. 6 E

Well No. # 1 Haldreth Farm

Saco Oil Company

Saco Contractor

Wildcat


_____ Ft. from N. Line

990 Ft. from S. Line

_____ Ft. from E. Line

330 Ft. from W. Line

NW SW SW

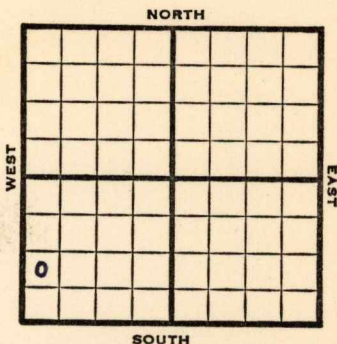

1953

Elev. 1377'

REPORT

5/13

Spud 5-9-53

15" @ 319

6/10

Spud 5-9-53

D & A TD 2841 15" @ 319

10" @ 1572 **Lans 1762** 8" @ 2288

KC 2145 Miss 2790

TD 2841

D & A

ABANDONED

