



Sec. 2 Twp. 15 319<sup>v</sup> R. 13-W

Well No. #1 Lipprand Farm

Stanolind Company

(Semi-Wildcat)

*Snider*


330 Ft. from N. Line

\_\_\_\_\_ Ft. from S. Line

\_\_\_\_\_ Ft. from E. Line

330 Ft. from W. Line

Elev. 1778

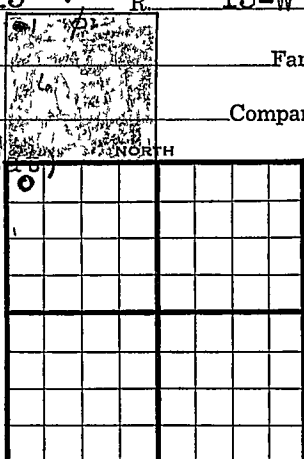

1942

REPORT

8/5 Derrick  
 8/12 10" @ 492 WOC  
 8/19 Topeka 2633' Drlg. 2829'  
 8/27 Lans. 2946 SSO 2979-91  
 Stains 3032-38 Cong. 3250  
 Arb. 3262  
 T.D. 3416 No shows  
 Shut down.  
 9/2 7" - 2968 Drilled out to 3020  
 T.D. 3020 - 3/4 bbl water per hr  
 trace oil 500 acid.  
 9/9 2500 acid swb 1/4 bbl soil & 5 1/2 bbls  
 W per - 8 hrs Shut down.  
 9/16 Lans. 2946  
 Arb. 3262  
 water  
 T.D. 3416'

ABANDONED

Rus sell

KANSAS

Map No. 73 Sec. 2 Twp. 15 R. 13W

Well No. 1 Lipprand

Stanolind

Company

**FIRST REPORT**

Contractor

NW/C

SECTION PLAT

0			

330 Ft. from N. Line

\_\_\_\_\_ Ft. from S. Line

\_\_\_\_\_ Ft. from E. Line

330 Ft. from W. Line

**SEMI-WILDCAT**

Location \_\_\_\_\_

Rig up \_\_\_\_\_

Drilling and Remarks:  
**Derrick**

RECORD

Cased \_\_\_\_\_ in., \_\_\_\_\_ ft.

Sand \_\_\_\_\_

Gas \_\_\_\_\_

Oil \_\_\_\_\_

Total Depth \_\_\_\_\_

PRODUCTION

1st 24 hrs. Nat. \_\_\_\_\_

1st 24 hrs. after shot \_\_\_\_\_

Gas \_\_\_\_\_ Cu. Ft.

Dry Hole \_\_\_\_\_

Abandoned \_\_\_\_\_

Date

AUG 5 1942

S. J. LEWIS Scout

