

Section 7 Township 29 Range 6 EWell No. #2 FrenchCompany Aylward Drlg.

NORTH

0							

WEST

EAST

SOUTH

Butler

KANSAS

SEC.

TWP.

R.

7

29

6E

WELL NO.

#2 French

FARM

COMPANY

Aylward Drlg.

CONTRACTOR

Smitherman

Fox-Bush


Ft. from N. Line

Ft. from S. Line

Ft. from E. Line

Ft. from W. Line

SW NW SW

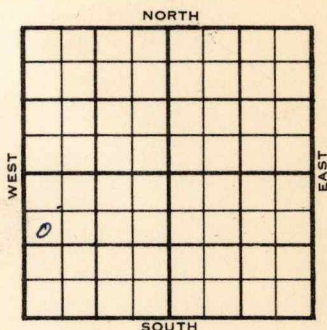

1956

ELEVATION

REPORT

2-29

MIR

3-14

Comm. 3-1-56

8 5/8" @

DST 2853-69 op 1½ hrs. rec. 220' fluid
(40' free oil) 310/20"

D & A

M. Chert 2856

M. Lm 2859

TD 2869

ABANDONED

County

~~Butler~~

Elev.

Sec.

7

Twp.

29

Rge.

6E

Company

~~Aylward Drlg.~~

Farm Name

French

No.

2

TOPS

DEPTH

LOG

DATUM

Loc. in Sec.

Anh.

SW NW SW

Tp.

H.

Tr.

Dg.

BL.

L.

K.C.

B.K.C.

Ce.

C.

M.

M.

K.

Mz.

Mq.

V.

S.

S.

A.

R.

Pe.

G.

T.D.

Geol.

Contr.

Smitherman

Pool

Fox-Bush

FIRST REPORT

FEB 29 '56

Date Comm.

M I R

Co.

Lse.

No.

Sec.

T.

R.

Co.

County Butler Elev. _____
 Sec. 7 Twp. 29 Rge. 6E
 Company Aylward Drlg.
 Farm Name French No. 2

TOPS	DEPTH	LOG	DATUM	Loc. in Sec.
Anh.				SW NW SW
Tr.				
H.				
Tr.				
Dg.				
Bl.				
L.				Geol. _____
K.C.				Contr. _____
B.K.C.				Smitherman
Ce.				Pool
C.				Fox-Bush
M. <u>Chert</u>	<u>2856</u>			
M. <u>ln</u>	<u>2859</u>			
K.				
Mz.				
Me.				
V.				
S.				
S.				
A.				
R.				
PE.				
G.				
T.D.	<u>2869</u>			

Lse.

No.

Sec.

T.

R.

Date Comm. 3-1-56 MAR 14 1956
8 5/8" @ DST 2853-69 open 1 1/2 hr.
rec. 220' fluid (40' free oil) 310/20"

D & A