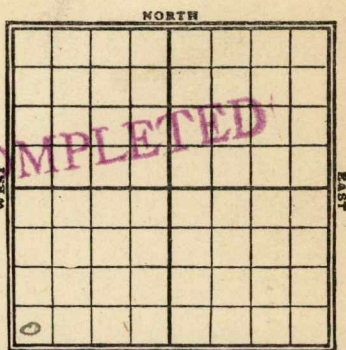


Map No. K Sec. 7 Twp. 29 R. 6Well No. 1 Meyers Farm
Carter Oil Company Ft. from N. Line250 Ft. from S. Line Ft. from E. Line250 Ft. from W. LineSOUTH
FIRST REPORT

REPORT

Date	
12/17	Dr 460'
11/17/20	Dr 1050'
23	Dr 1300'
29	Dr 1460'
21/2	Dr 8 1/4 to 1657'
11	Dr 8 1/4 to 1657'
24	Dr 1720
3/3	✓ 1895'
23	✓ 2270
4/2	✓ 2375
9	✓ 2518
4/4	SD 2861
5/22	2837-61 Stat 30 ft 30 ft.

Map No. K 11 Sec. 7 Twp. 29 R. 6Well No. 1 Meyers
The Carter Oil Company

Contractor _____

SECTION PLAT

_____ Ft. from N. Line

250 Ft. from S. Line

_____ Ft. from E. Line

250 Ft. from W. Line

CHANGE FEE NAME

Location _____

Rig up _____

Drilling and Remarks:

RECORD

Cased _____ in., _____ ft.

Sand _____

Gas _____

Oil _____

Total Depth _____

PRODUCTION

1st 24 hrs. Nat. _____

1st 24 hrs. after shot _____

Gas _____ Cu. Ft.

Dry Hole _____

Abandoned _____

Date

12/17 1919

Pyle

Scout

Map No. K11 Sec. 7 Twp. 29 R. 6Well No. 1 MeyersThe Carter Oil Company

Contractor

SECTION PLAT

Ft. from N. Line

250 Ft. from S. Line

Ft. from E. Line

250 Ft. from W. Line

COMPLETED

Location

Rig up

Drilling and Remarks:

Shot 30 gts

RECORD

Cased _____ in., _____ ft.

Sand 2837-61

Gas _____

Oil _____

Total Depth _____

PRODUCTION

1st 24 hrs. Nat. _____

1st 24 hrs. after shot 30 bbls

Gas _____ Cu. Ft.

Dry Hole _____

Abandoned _____

Date

5/20 1920

Pyle

Scout