

Butler KANSAS

Section 7 Township _____ Range 6EWell No. #1 WelchCompany Rex & Morris

							0

NORTH

WEST

EAST

SOUTH

Butler

KANSAS

Sec. 7 Twp. 29 R. 6E

Well No. #1Welch Farm

Rex & Morris Company

Rek & Morris Contractor

Semisch Pool


_Ft. from N. Line

990 Ft. from S. Line

330 Ft. from E. Line

_Ft. from W. Line

NE SE SE

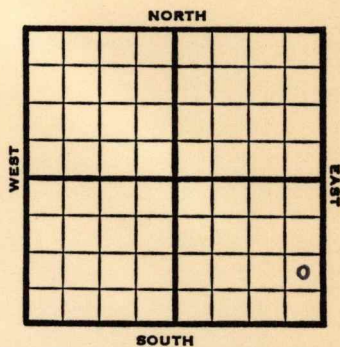

1953 Elev. 1407' REPORT

7/1	Spud 6-28-53 8"@ 67 Drlg. 218'
-----	--------------------------------------

7/8 Spud 6-28-53
8" @ 67 Bart. 2836
Miss 2861 TD 2881
D & A

ABANDONED

County **Butler** State **Kansas**

Sec. 7 (Blk.) 29 (Sur.) 6E Map No.

Operator Bex & Morris

Well No. 1 Farm Welch

Elev.	Location
	NE SE SE

FIRST REPORT

990 Ft. From S Line SE

330 Ft. From  Line Quarter

1st. Report JUL 1 1953

Completion

Remarks

Rex & Morris - Contr.

Spudding Date 6-28-53

Drlg. Data Semisch Pool

8" @ 67 drlg. 218

J. G. McGEHEE

County Butler State KansasSec. 7 (Blk. Twp.) 29 (Sur. Rge.) 6E Map No. 12249Operator Rex & MorrisWell No. 1 Farm WelchElev. 1407 Location NE SE SE990 Ft. From S Line SE330 Ft. From E Line Quarter1st. Report Completion JUL 8 1953Remarks Semisch PoolRex & Morris - Contr.Spudding Date 6-28-53

Drlg. Data

8" @ 67 Bart. 2836 Miss. 2861 TD 2881D & A

J. G. McGEHEE