


*has Sec 3  
but on Sec # 8  
inside of Sec 6.*  
Section 3 Township 29

Range 6E

Well No. #2 Price \_\_\_\_\_

Company Rex & Morris

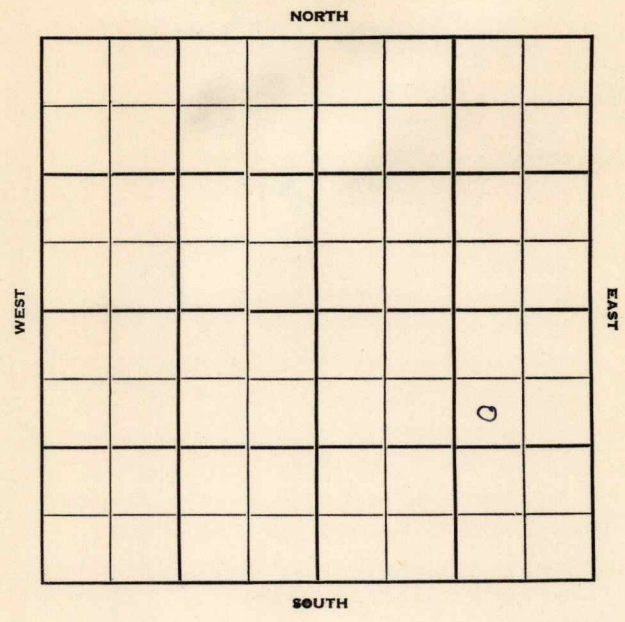

Butler

KANSAS

Sec. 8 Twp. 29 R. 6E

Well No. #2 Price Farm

Rex & Morris Company

Rex & Morris - Contr. Contractor

Semisich


990' Ft. from N. Line

Ft. from S. Line

990' Ft. from E. Line

Ft. from W. Line

SW NE SE

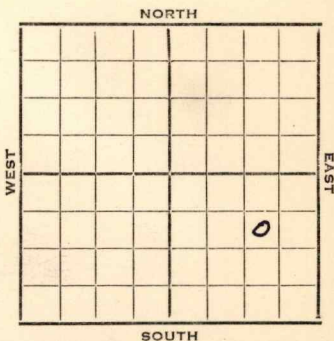

1952 Elev. 1408' REPORT

3/26 Location  
 4/16 Spud 3-26-52  
 Oil Well TD 2818  
 8" @ 57  
 KC 2155 BKC 2365  
 Bart 2768 TD 2780  
 5" @ 2769 DD 2818  
 PB 2817 Hydra Comp. 35 bopd

COMPLETED



