


Section 4 Township 16 Range 10W

Well No. 1 Borecky

Company Henderson Oil

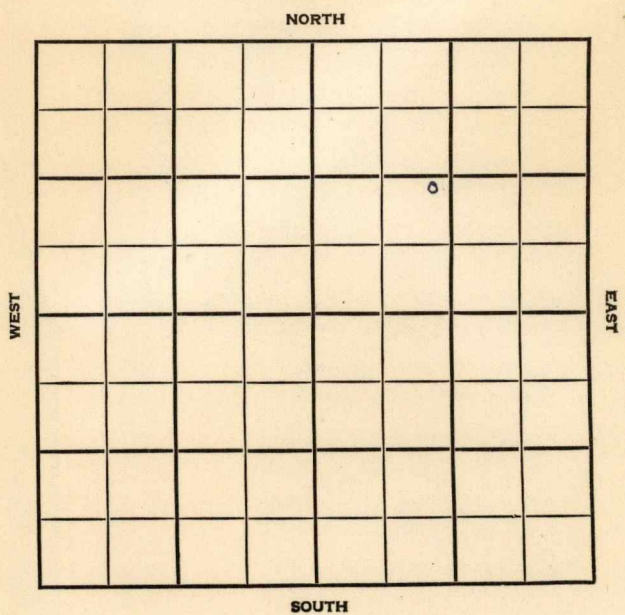

Ellsworth

KANSAS

SEC.	TWP.	R.
4	16	10W

WELL NO. #1 Borecky FARM

COMPANY Henderson Oil


CONTRACTOR Lewis Drlg
Progress NW

_____ Ft. from N. Line

_____ Ft. from S. Line

_____ Ft. from E. Line

_____ Ft. from W. Line

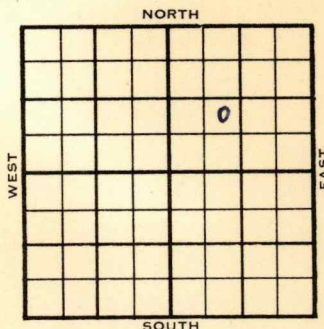

NE SW NE

1955	ELEVATION	REPORT
	1765'	

6/29

Comm 5-7-55

H 2796

Dg 2826

Bl 2897

L 2917

KC 3063

BKC 3188

Cong 3234

M Cong Sd 3282

A 3303

TD 3311

8" @ 319/150 DST 3304-11 open 1 hr

Rec 2220' oil 120/15" 5" @ 3304

CO to 3311 FU 2000' oil 1 hr

FU 3000' oil 4 hr S/29 bo 1 hr

Comp 1520 bopd

FIRST REPORT

+

COMPLETED

County Ellsworth Elev. 1765

Sec. 4 Twp. 16 Rge. 10W

Company Henderson Oil

FarmName Borecky No. 1

Co.

L.se.

No.

Sec.

T.

R.

TOPS	DEPTH	LOG	DATUM
Anh.			
Tp.			
H.	<u>2796</u>		<u>1031</u>
Tr.			
Dg.	<u>2826</u>		<u>1061</u>
Bl.	<u>2897</u>		<u>1132</u>
L.	<u>2917</u>		<u>1152</u>
K.C.	<u>3062</u>		<u>1297</u>
B.K.C.	<u>3188</u>		<u>1423</u>
Ce.			
C. <u>orig</u>	<u>3234</u>		<u>1465</u>
M. <u>Compd</u>	<u>3282</u>		<u>1517</u>
M.			
K.			
Mz.			
Mq.			
V.			
S.			
S.			
A.	<u>3303</u>		<u>1538</u>
R.			
Pe.			
G.			
T.D.	<u>3311</u>		

Loc. in Sec. NE SW NE

Geol. _____

Contr. _____

Lewis D. lg.

Pool Progress NW



6-29-55
COMPLETE
FIRST REPORT

Date Comm. 5-7-55 JUN 29 1955

8" @ 319/150 DST 3304-11 open 1 hr.

Rec. 2220' oil 1120/15" 5" @ 3304

CO to 3311 FU 2000' oil 1 hr.

FU 3000' oil 4 hr. S/ 29 bo 1 hr.

Comp. 1520 bopd