


Ellsworth

KANSAS

SECTION 4 TOWNSHIP 16 RANGE 10 W

WELL NO. #1 Sebesta

COMPANY Grant Oil

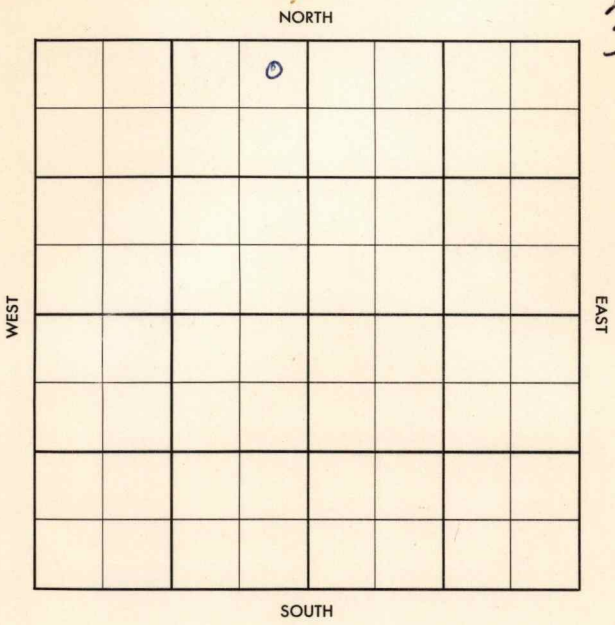

Ellsworth

KANSAS

SEC.

TWP.

R.

4

16

10W

WELL NO.

#1 Sebesta

FARM

COMPANY

Grant Oil

CONTRACTOR

Dutch George


_____ Ft. from N. Line

_____ Ft. from S. Line

_____ Ft. from E. Line

_____ Ft. from W. Line

NE NE NW

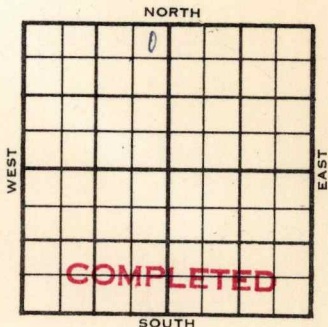

ELEVATION

REPORT

1955

12-21- Surface Hole

27

County Ellsworth Elev. 1718
 Sec. 4 Twp. 16 Rge. LOW
 Company Grant Oil
 Farm Name Sebesta No. 1

TOPS	DEPTH	LOG	DATUM	Loc. in Sec.																					
Anh.				NE NE NW																					
Tr.	2767																								
Bl.	2847			100 NL																					
L.	2864		1146	50 EL																					
K.C.				Geol.																					
B.K.C.				Contr.																					
Ce.	3188		1480	Dutch George																					
M.				Pool																					
V.				<table border="1"> <tr><td></td><td>0</td><td></td></tr> <tr><td></td><td></td><td></td></tr> <tr><td></td><td></td><td></td></tr> <tr><td></td><td></td><td></td></tr> <tr><td></td><td></td><td></td></tr> <tr><td></td><td></td><td></td></tr> <tr><td></td><td></td><td></td></tr> </table>		0																			
	0																								
S.	3214		1496																						
S.	3246		1528																						
A	3269		1551																						
R.																									
PE																									
G.																									
TD	3273																								

Date Comm. MAR 7 1956
surface hole DEC 28 '55 12-21-55
8 5/8 246 Ø 1900 JAN 5 '56
Ø 2965 JAN 11 '56 DST 3270-73
2 hrs rec 50' clear oil + 50'
OCM 13HP 1070/20 5 1/2 3-70
JAN 18 '56 CO 3273 \$ 1 1/2 Bopk
4 hrs 1 1/2 \$ 48 Bop in 8 hrs
Pop JAN 25 '56 ✓ FEB 1 '56 ✓ FEB 8 '56
FEB 15 '56 ✓ FEB 22 '56 WOP JT FEB 29 '56

MAR 7 '56

Ph P. 170 Bopd notes

graw 32°

R.G.

MAR 19 1956

vb

CONFIDENTIAL

Co.

Sec.

No.

Sec.

T.

R.

County Ellsworth Elev. LOW
 Sec. 4 Twp. 16 Rge. LOW
 Company Grant Oil
 Farm Name Sebesta No. 1

TOPS	DEPTH	LOG	DATUM	Loc. in Sec.
Anh.				NE NE NW
TP.				
H.				
Tr.				
Dg.				
Bl.				
L.				Geol.
K.C.				Contr.
B.K.C.				Dutch George
Ce.				Pool
C.				
M.				
M.				
K.				
Mz.				
Mq.				
V.				
S.				
S.				
A				
R.				
Pe.				
G.				
T.D.				

0

FIRST REPORT

DECEMBER 1955

Date Comm. surface hole

~~13~~