


Section 3 Township 15 Range 13 W

Well No. # 1 Michael

Company Fred Haynes

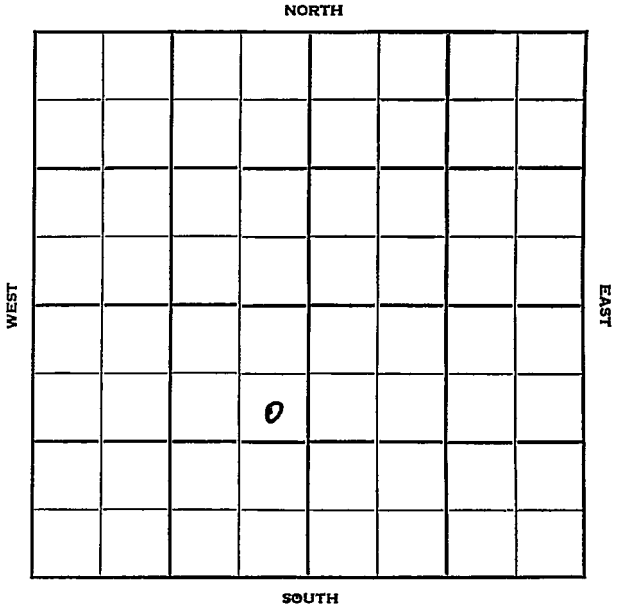

Sec. 3 Twp. 15 R. 13W

Well No. #1 Michael Farm

Fred Haynes Company


Haynes Contractor

990 Ft. from N. Line

_____ Ft. from S. Line

330 Ft. from E. Line

_____ Ft. from W. Line

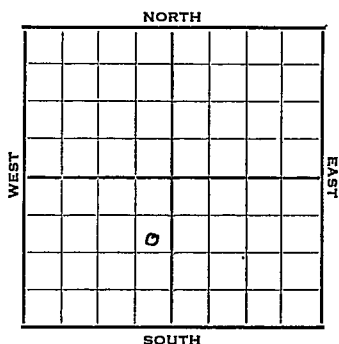

SE NE SW

1952 Elev. 1801' REPORT

- 6/18 Spud 6-15-52
Drlg. 180'
- 6/25 Anhy 784' 10" @ 786'
Drlg. 1160'
- 7/2 Drlg. 2070'
- 7/9 8" @ 2410
Drlg. 2480'
- 7/17 Topeka 2682 SSO 2940-45
KC 2990
Drlg. 3195'
- 7/23 Spud 6-15-52
D&A TD 3308
Anhy 784 10" @ 786
8" @ 2410 Top 2682
KC 2990 Arb. 3260
TD 3308 D&A

County Russell State Kansas

Sec. 3 (Blk. Twp.) 15 (Sur. Rge.) 13W Map No.

Operator Fred Haynes

Well No. 1 Farm Michael

Elev. _____ Location SE NE SW

990 Ft. From N Line SW

330 Ft. From E Line Quarter

1st. Report JUN 18 1952

Completion _____

Remarks _____

Haynes - Contr.

Spudding Date 6-15-52

Drlg. Data Trapp

Drlg. 180

County Russell State Kansas

Sec. 3 (Blk. Twp.) 15 (Sur. Rge.) 13W Map No.

Operator Fred Haynes

Well No. I Farm Michael

Elev. 1801 Location SE NE SW

ABANDONED

990 Ft. From N Line SW

330 Ft. From E Line Quarter

1st. Report

Completion Jul 23 1952

Remarks Trapp Pool

Haynes - Contr.

Spudding Date 6-15-52

Drlg. Data D & A TD 3308

Anhy 784 10" @ 786 8" @ 2410

Top. 2682 KC 2990 Arb. 3260

TD 3308

D & A