
FORM 51 25M 8-50 WESTERN Russell KANSAS

Section 3 Township 15 Range 13 W

Well No. # 4 Shaffer

Company H. B. Shoemaker et al

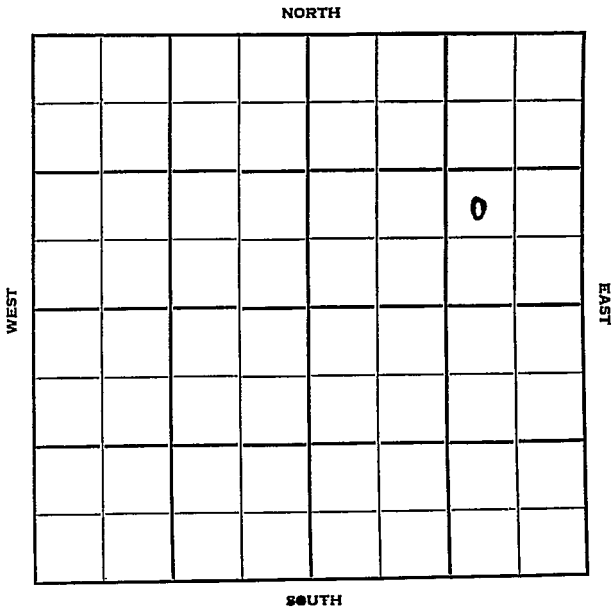

FORM 252-B
10M 8-51 TPCO.

Russell KANSAS ✓

Sec. 3 Twp. 15 R. 13 W

Well No. # 4 Shaffer Farm

H. B. Shoemaker et al Company

Jones, Shelburne, & Farmer Contractor
Hall Gurney


Ft. from N. Line

990 Ft. from S. Line

990 Ft. from E. Line

Ft. from W. Line

NW SE NE

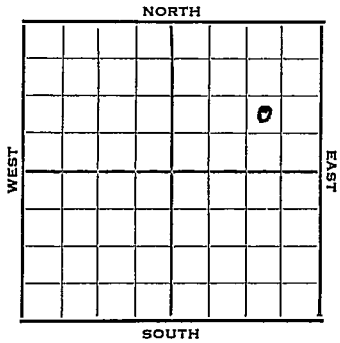

1952	Elev. 1843' REPORT
7/2	Location
7/9	"
7/17	13" @ 489 Drlg. 675
7/23	Anhy 794' 10" @ 800' Drlg. 1645'
7/30	Drlg. 2360'
8/6	8" @ 2430' Drlg. 2625'
8/13	7" @ 3075'
8/20	TD 3100 150A
8/27	NR
9/3	4000 A F 34 Boph
9/10	NR
9/17	"
9/24	Spud 7-9-52 Oil Well TD 3100' 13" @ 489' Anhy 794' 10" @ 800' 8" @ 2430' 7" @ 3075' TD 3100 150 A 4000 A F/ 34 boph Top. 2715 Lans. 3015 5" @ 3090' Comp. 50 bopd

COMPLETED

FORM 275 FOR SALE BY KANSAS BLUE PRINT CO.


County Russell State Kansas

Sec. 3 (Blk. Twp.) 15 (Sur. Rge.) 13W Map No.

Operator H. B. Shoemaker et al.

Well No. 4 Farm Shaffer

Elev. Location NW SE NE

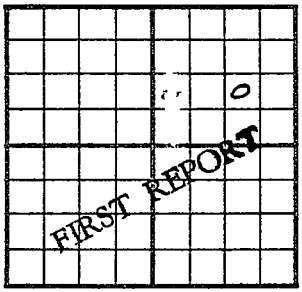

990 Ft. From S Line NE

990 Ft. From E Line Quarter

1st. Report JUL 2 1952

Completion

Remarks

Jones, Shelburne & Farmer-Contr.

Spudding Date

Drlg. Data Hall Gurney

Location

J. G. McGEHEE

FORM 275 FOR SALE BY KANSAS BLUE PRINT CO.


County Russell State Kansas

Sec. 3 (Blk. Twp.) 15 (Sur. Rge.) 13W Map No.

Operator H. B. Shoemaker etal.

Well No. 4 Farm Shaffer

Elev. 1843 Location NW SE NE

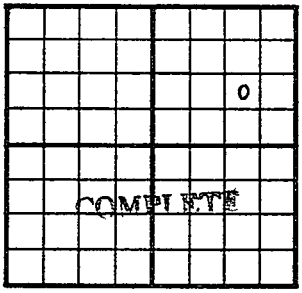

990 Ft. From S Line NE

990 Ft. From E Line Quarter

1st. Report

Completion SEP 2 4 1952

Remarks Hall-Gurney Pool
J-S-F- Contr.

Spudding Date 7-9-52

Drlg. Data Oil well TD 3100

13" @ 489 Anhy 794 10" @ 800

8" @ 2430 7" @ 3075 TD 3100 150 A

4000 A F/ 34 boph Top. 2715

Lans. 3015 5" @ 3090 Comp. 50 bopd

J.J.G.M.C.B.S.E