



Well No. 1 Weimeister

Company W. I. Southern

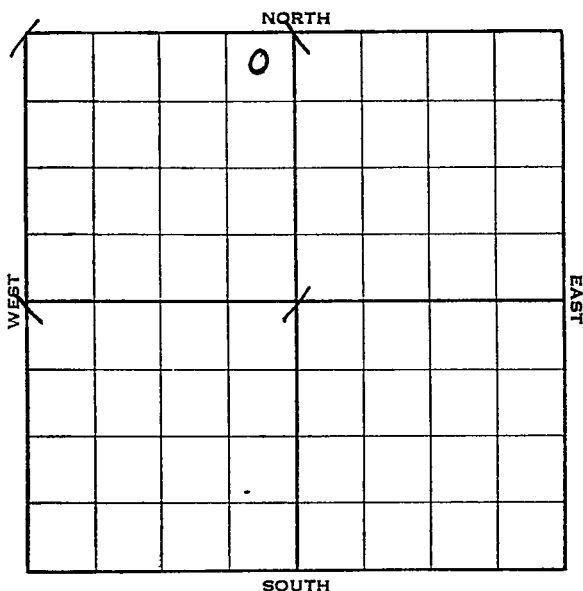

KANSAS

Russell

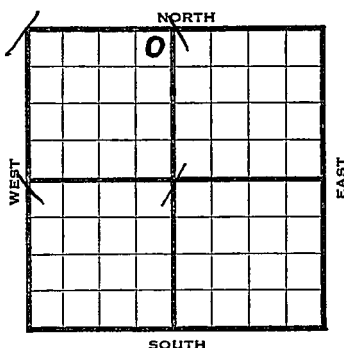Sec. 3 Twp. 15 R. 13-WWell No. #1 Weimeister FarmW. I. Southern Company330 Ft. from N. Line Ft. from S. Line330 Ft. from E. Line Ft. from W. Line

Elev. 1780

1938	REPORT
8/24	10" - 260'. WOC.
9/2	Dlg. 2540'.
9/9	K. C. 2972'. 7" - 2976'.
9/16	T. D. 2990'. S. O. 5000 acid.
	No help. Will deepen.
9/23	P. B. 2988'. 4000 acid.
	Pump 30 oil & 75 water in 24 hrs.
	Dlg. deeper.
9/30	Arb. 3299'. T.D. 3300' S. W.
	P. B. to Lansing.
10/7	P. B. 2984'.
10/14	" "
10/19	7" - 2976'.
	Lans. 2972'.
	Arb. 3299'.
	T. D. 3300'.
	P. B. to 2984'.
	ABANDONED

Russell

KANSAS

Map No. 73 Sec. 3 Twp. 15 R. 13WWell No. 1 WeimeisterW. I. Southern

Company

Contractor

FIRST REPORT

NE NW


330 Ft. from N. Line

Ft. from S. Line

330 Ft. from E. Line

Ft. from W. Line

SECTION PLAT

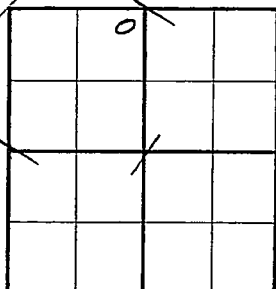

Location

RECORD

Cased _____ in., _____ ft.

Sand _____

Gas _____

Oil _____

Total Depth _____

PRODUCTION

1st 24 hrs. Nat. _____

1st 24 hrs. after shot _____

Gas _____ Cu. Ft.

Dry Hole _____

Abandoned _____

Drilling and Remarks:

10" - 260WOC

Date

AUG 24 1938H. D. Hatfield Scout

Russell KANSAS

Map No. _____ Sec. 3 Twp. 15 R. 13WWell No. 1 WeimeisterW. I. Southern Company

Contractor _____

ABANDONED

NE NW

330 Ft. from N. Line

_____ Ft. from S. Line

330 Ft. from E. Line

_____ Ft. from W. Line

SECTION PLAT

	0		

Location _____

Rig up _____

Drilling and Remarks:

RECORD

Cased 7 in., 2976 ft.Sand LENS 2972Gas ARB 3 299

Oil _____

Total Depth 3300

PRODUCTION

1st 24 hrs. Nat. _____

1st 24 hrs. after shot _____

Gas _____ Cu. Ft.

Dry Hole _____

Abandoned _____

DVA

Date

OCT 19 1938

19

H. D. Hatfield

Scout