


Section 3 Township 15 Range 13 W

Well No. # 2 Weimaster

Company Gabbert-Jones Drlg.

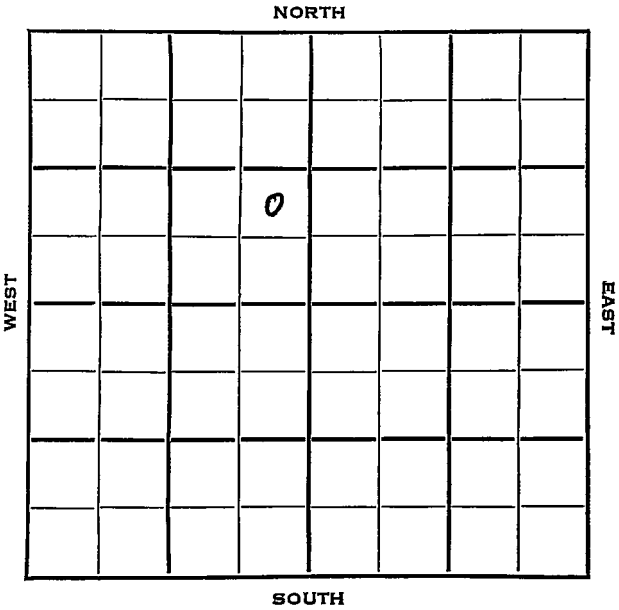


Russell

KANSAS ✓

Sec. 3 Twp. 15 R. 13WWell No. #2 Weimaster FarmGabbert-Jones Drlg. CompanyGabbert-Jones Contractor Ft. from N. Line990 Ft. from S. Line330 Ft. from E. Line Ft. from W. Line

NE SE NW

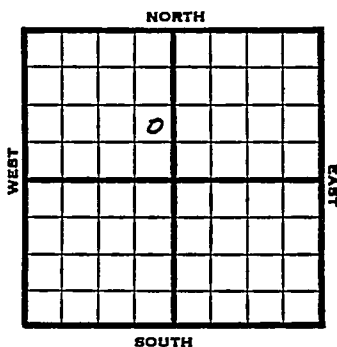

1953 Elev. 1830' REPORT

6/10 C & P

6/24 "

7/1 "

7/22 8" @ 150 w/125
 Anhy 785'
 Drlg. 2400'

7/29 Drlg. 2995'

8/5 Spud 7-14-53

D&A

TD 3312

8" @ 150

Anhy 785, Lans 2995,

DST 3034-48, opn 1 hr., rec. 30' ocm,

DST 3066-81, opn 1 hr., rec. 40' ocm,
285#

Cong 3310

TD 3312

D&A

ABANDONED

County **Russell** State **Kansas**

Sec. **3** (Blk. **15** (Sur. **13W** Map No.

Operator Gabbert-Jones Drig.

Well No. 2 Farm Weimaster

Elev.	Location	NE	SE	NW
-------	----------	----	----	----

FIRST REPORT

990 Ft. From S Line INF

330 Ft. From E Line Quarter

1st. Report JUN 10 1953

Completion

Remarks

Gabbert-Jones - Contr.

Spudding Date .

Drlg. Data ..

Cellar & pits

County Russell State Kansas
 Sec. 3 (Blk.) 15 (Sur.) 13W Map No.
 Operator Gabbert-Jones
 Well No. 2 Farm Weimaster
 Elev. 1830 Location NE SE NW



990 Ft. From S Line NW
330 Ft. From E Line Quarter

1st. Report

Completion AUG 3 1953

Remarks

Gabbert-Jones - Contr.

Spudding Date 7-14-53

Drlg. Data D & A TD 3312

8" @ 150 Anhy 785 Lans. 2995

DST 3034-48 open 1 hr. Rec. 30' ocm

DST 3066-81 open 1 hr. Rec. 40' ocm

285# Cong. 3310 TD 3312

D & A

J. G. McGEHEE