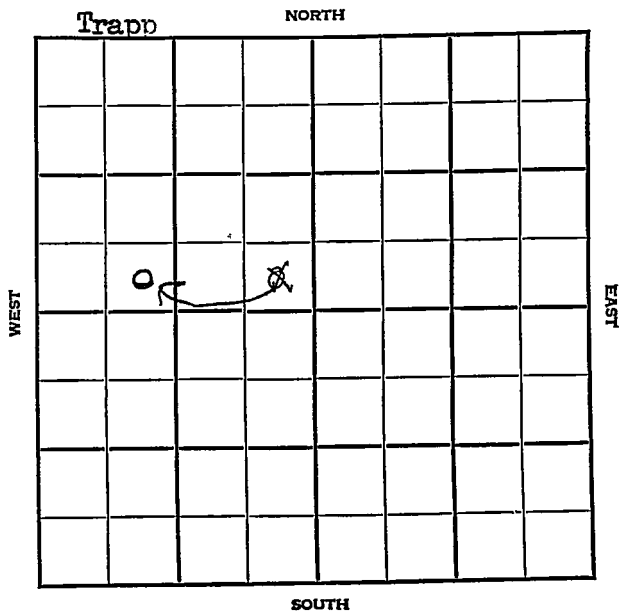


KANSAS

Section 4 Township 15 Range 13WWell No. 1 HaffermanCompany B. & R. Drlg.

KANSAS

Russell

Sec. 4 Twp. 15 R. 13W

Well No. #1 Hafferman Farm

B & R Drlg. Company

Trapp Pool

 Ft. from N. Line


330' Ft. from S. Line

330' Ft. from E. Line

990 Ft. from W. Line

~~SE NW~~

SE SW NW

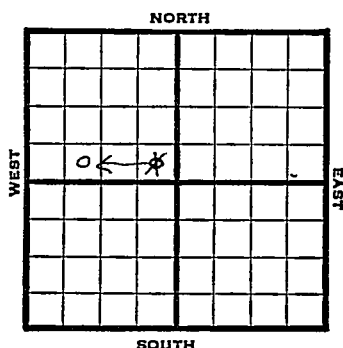

1948 El. 1791' REPORT

3/3 RUR

3/10 8" @ 185'
Drlg. 2905'

3/17 Lansing 2968'
Arbuckle 3264'
TD 3300'
5" @ 3220'
RUST

3/24 "

3/31 "

4/7 "

4/14 "

4/21 "

4/28 24 shots 3167-75'
24 shots 3097-3109'
12 shots 2994-98'
12 shots 2976-80'
12 shots 2968-72'

5/5 Squeeze PB 2942'
12 shots 2936-40' - 2000 acid.
Swb. 2 bbls. oil PH 6 hrs.

5/12 "

5/19 "

5/26 "

6/1 "

OVER

1948

6/9 Squeeze PB 2942-
12 shots 2936-40 - 2000 acid
Swb 2 bbls oil PH oil 6 hrs.

6/16 "

6/23 TD 3300'
Lans. 2968'
Arb. 3264'
5"@ 3220'
Perf Lans 2000 acid
Pump 12 oil Pot
40⁹ Gr.
Comp.

COMPLETED

Map No. _____ Sec. 4 Twp. 15 R. 13W

Well No. 1 Hafferman

B & R Drlg. Company

FIRST REPORT

Contractor

SE NW


SECTION PLAT

 Ft. from N. Line

330 Ft. from S. Line

330 Ft. from E. Line

330 Ft. from W. Line

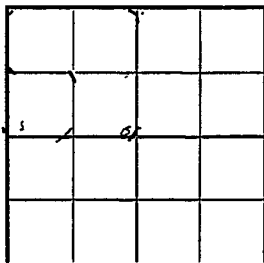

Russell County

Location _____

Rig up _____

Drilling and Remarks:

R U R

RECORD

Cased _____ in., _____ ft.

Sand _____

Gas _____

Oil _____

Total Depth _____

PRODUCTION

1st 24 hrs. Nat. _____

1st 24 hrs. after shot _____

Gas _____ Cu. Ft.

Dry Hole _____

Abandoned _____

Date

MAR 3 1948

19

S. J. LEWIS

Scout

Map No. 73 Sec. 4 Twp. 15 R. 13W

Well No. 1 Hafferman

B & R Drlg. Company

CORRECTION Contractor

SE SW NW

SECTION PLAT

 Ft. from N. Line

330 Ft. from S. Line

 Ft. from E. Line

990 Ft. from W. Line

Russell County

Location

Rig up

Drilling and Remarks:

Reported SE NW

RECORD

Cased in., ft.

Sand

Gas

Oil

Total Depth

PRODUCTION

1st 24 hrs. Nat.

1st 24 hrs. after shot

Gas Cu. Ft.

Dry Hole

Abandoned

Date

MAR 10 1948

19

S. J. LEWIS

Scout

Map No. 73 Sec. 4 Twp. 15 R. 13W

Well No. 1 Hafferman

B & R Drlg.

Company

COMPLETE

Contractor

SE SW NW

E 1, 1791
SECTION PLAT

	0		

Ft. from N. Line

330 Ft. from S. Line

Ft. from E. Line

990 Ft. from W. Line

Russell County

Location

Rig up

Drilling and Remarks:

Lime 2965

Car 7 3264

5 3220

Prof. Lanes.

Locoacis

Pump 12 oil 120

Date

40 9/22

RECORD

Cased _____ in., _____ ft.

Sand _____

Gas _____

Oil ☒ _____

Total Depth 3300

PRODUCTION

1st 24 hrs. Nat. _____

1st 24 hrs. after shot _____

Gas _____ Cu. Ft.

Dry Hole _____

Abandoned _____

JUN 23 1948

19

S. J. LEWIS

Scout