

KANSAS

Russell

FORM 51 5M 4-41 PETROL

Section 3 Township 15 Range 13-W


Well No. #1 Schaffer

Company H. B. Snider et al

O. W. D. D.

NORTH

Wildcat

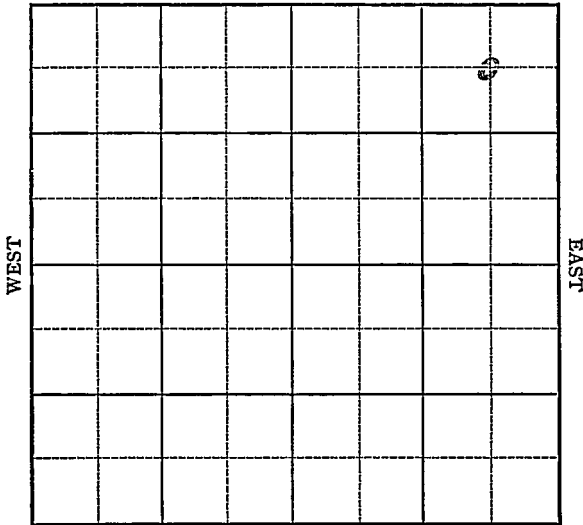

SOUTH



1942
7/15

Lans. 2968'
7" - 2970'
T.D. 2998'
10,000 acid.
Potential 591 bbls., pump.
39. Gravity

COMPLETED

1942
8/4

O W D. D.

OTD 2998'
Comp. 7/15/42 in Lansing, topped
at 2968' for 591 bbls oil, no water.
Drld deeper to 3060 TD
Hole filled 2300' of fluid, no
estimate amount of water.
Plugged back to 3028' and
pumped 50 bbls of oil in $7\frac{1}{2}$ hours
plus 8 bbls of water per hour.
Then completed it for the old
potential, 591 barrels.

~~(letter)~~

FIRST REPORT
+
COMPLETED

Map No. 73 Sec. 3 Twp. 15 R. 13WWell No. 1 SchafferR. B. Snider et al. CompanyCOFFECTION Contractor

C NE NE

SECTION PLAT

| | | | |
|--|--|--|---|
| | | | o |
| | | | |
| | | | |
| | | | |

660 Ft. from N. Line

_____ Ft. from S. Line

660 Ft. from E. Line

_____ Ft. from W. Line

WTLDCAT

Location _____

Rig up _____

Drilling and Remarks:

Reported

C SL NE NE

RECORD

Cased _____ in., _____ ft.

Sand _____

Gas _____

Oil _____

Total Depth _____

PRODUCTION

1st 24 hrs. Nat. _____

1st 24 hrs. after shot _____

Gas _____ Cu. Ft.

Dry Hole _____

Abandoned _____

Date

MAY 23 1942 19S. J. LEWIS Scout

Russell

KANSAS

Map No. _____ Sec. 3 Twp. 15 R. 13W

Well No. 1 Schaffer


R. B. Snider et al. Company

FIRST REPORT

Contractor

C SL NE NE

SECTION PLAT

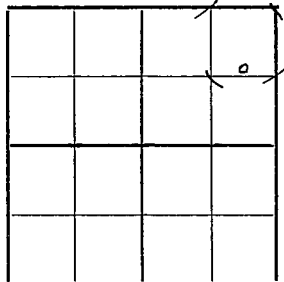

990 Ft. from N. Line

_____ Ft. from S. Line

660 Ft. from E. Line

_____ Ft. from W. Line

WILDCAT

Location _____

Rig up _____

Drilling and Remarks:

Machine

Special

RECORD

Cased _____ in., _____ ft.

Sand _____

Gas _____

Oil _____

Total Depth _____

PRODUCTION

1st 24 hrs. Nat. _____

1st 24 hrs. after shot _____

Gas _____ Cu. Ft.

Dry Hole _____

Abandoned _____

Date

MAY 20 1942

19

S. J. LEWIS Scout

Russell

KANSAS

Map No. 73 Sec. 3 Twp. 15 R. 13W

Well No. 1 Schaffer

R. B. Snider et al. Company

COMPLETED

Contractor

C NE NE

SECTION PLAT

660 Ft. from N. Line

_____ Ft. from S. Line

660 Ft. from E. Line

_____ Ft. from W. Line

| | | | |
|--|--|--|---|
| | | | 9 |
| | | | |
| | | | |
| | | | |

WILDCAT

Location _____

Rig up _____

Drilling and Remarks:

*Loss 2968.
7" @ 2970
10000 Acid
Pump 591 P.S.*

39 2/3

RECORD

Cased _____ in., _____ ft.

Sand _____

Gas _____

Oil _____

Total Depth 2998.

PRODUCTION

1st 24 hrs. Nat. _____

1st 24 hrs. after shot _____

Gas _____ Cu. Ft.

Dry Hole _____

Abandoned _____

Date

JUL 15 1942 19

S. J. LEWIS Scout

Russell

Map No. 23 Sec. 3 Twp. 15 R. 13WWell No. 1 SchaefferR. B. Snider et al. Company**COMPLETED**

Contractor

C NE NE

SECTION PLAT

660 Ft. from N. Line

_____ Ft. from S. Line

660 Ft. from E. Line

_____ Ft. from W. Line

| | | | |
|--|--|--|---|
| | | | 0 |
| | | | |
| | | | |
| | | | |

WILDCAT

O.W.D.D.

Location _____

Rig up _____

Drilling and Remarks:

*Lease 2968**2" C 2970**Old T&E 2998**PB 3028-2300' Fluid**Pump 50 oil in 7' 1/2" hole**Plus 544k Water**Per. No.**39-52*

RECORD

Cased _____ in., _____ ft.

Sand _____

Gas _____

Oil _____

Total Depth 3060

PRODUCTION

1st 24 hrs. Nat. _____

1st 24 hrs. after shot _____

Gas _____ Cu. Ft.

Dry Hole _____

Abandoned _____

Date

Aug 4 1942S. J. LEWIS Scout