

Russell KANSAS

SEC.	TWP.	R.
3	15	13W

WELL NO. 7 Shaffer . FARM

COMPANY S. A. Rudiger et al

CONTRACTOR Mai

Hall-Gurney Pool


1320 Ft. from N. Line

Ft. from S. Line

990 Ft. from E. Line

Ft. from W. Line

C W/2 E/2 NE

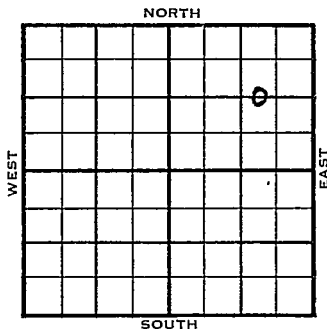

1954	ELEVATION 1843'	REPORT
------	--------------------	--------

10/6 Spud 9-30-54
 12" @ 283'
 10" @ 488'
 Anhy 790'
 8" @ 793'

10/27 Spud 9-30-54 - Gas Well
 TD 2385'
 12" @ 283'
 10" @ 488'
 8" @ 793'
 Tarkio 2265'
 TD 2385'
 7" @ 2380'
 Comp. Shut In Gas Well
 2,000,000 cfcpd

COMPLETED

