

DX 78-1 Ellsworth

KANSAS

Section 4 Township 16 Range 10W

Well No. #1 E. Sebesta

Company Texas Company

NORTH

SOUTH

WEST

EAST

9

0

Ellsworth

KANSAS

SEC. 4	TWP. 16	R. 10W
-----------	------------	-----------

WELL NO.

#1 E. Sebesta

FARM

COMPANY

Texas Company

CONTRACTOR

Stickle

WILDCAT


_____ FT. FROM N. LINE

_____ FT. FROM S. LINE

_____ FT. FROM E. LINE

_____ FT. FROM W. LINE

SW NE SE

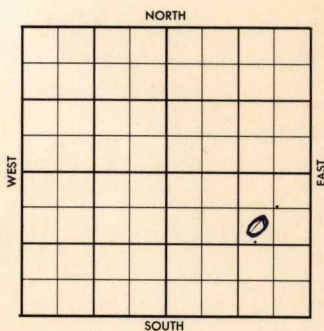

1956	ELEVATION 1806'	REPORT
------	--------------------	--------

8-22 Comm. 8-16-56
10" @ 314 w/175

8-29 DST 3234-69 op 1 hr., rec. 3½' mud,
FP 50-60#, BHP 170/20".
D & A

H. 2865'; Tr. 2888'; Dg. 2899';

BL. 2970'; L. 2984';

Log tops: H. 2866'; Tr. 2888'; BL. 2970';

L. 2984'; BKC 3275'; #. Shaley 3289';

S. 3401'; A. 3433';

TD 3452'

ABANDONED

Co.

County Ellsworth Elev. 1806
 Sec. 4 Twp. 16 Rge. 10W
 Company Texas Company
 Farm Name E. Sebesta No. 1

TOPS	DEPTH	LOG	DATUM	Loc. in Sec.
Anh.				SW NE SE
Tp.				
H.	2865	2866		
Tr.	2888	2888		
Dg.	2899			
Bl.	2970	2970		
L.	2984	2984		
K.C.				Geol.
B.K.C.		3275		Contr.
Ce.				
C. <i>shaley</i>		3289		Stickle
M.				
M.				Pool
K.				Wildcat
Mz.				
Me.				
V.				
S.		3401		
S.				
A.		3433		
R.				
Pe.				
G.				
T.D.	3452			

Loc.

No.

Sec.

T.

R

Date Comm. 8-16-56

AUG 29 1956

10" @ 314/175

AUG 29 '56 DST 3234

-69 1hr rec 3 1/2' Md FP

50-60 BHP 170/20"

D&A.

County

Ellsworth

Elev.

Sec.

4

Twp.

16

Rge.

LOW

Company

Texas Company

Farm Name

E. Sebesta

No.

1

TOPS	DEPTH	LOG	DATUM	Loc. in Sec.
Anh.				SW NE SE
Tp.				
H.				
Tr.				
Dg.				
BL.				
L.				Geol.
K.C.				Contr.
B.K.C.				Stickle
Ce.				Pool
C.				Wildcat
M.				
M.				
K.				
Mz.				
Mq.				
V.				
S.				
S.				
A.				
R.				
Pe.				
G.				
T.D.				

FIRST REPORT

AUG 22 56

Date Comm.

8-16-56

10" @ 314/175

2281 9 5 50A

13.51