

KANSAS

O. W. D. D


FORM 51 5M PETROL

Russell

Section 9 Township 14 Range 14-W

Well No. #1 Harry Krug

Company CKA Corstena

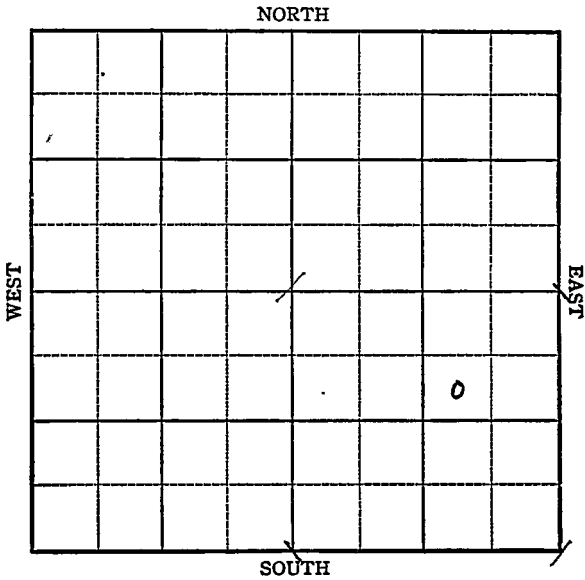


Sec. 9 Twp. 14 R. 14-W

Well No. #1 Harry Krug Farm

Coralena CKA Company

NORTH

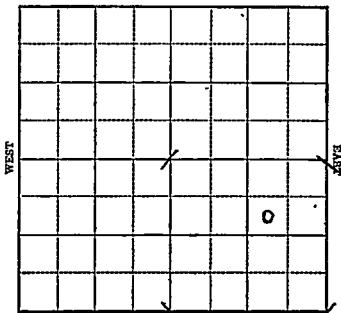

990 Ft. from N. Line

_____ Ft. from S. Line

990 Ft. from E. Line

_____ Ft. from W. Line

Elev. 1851

1943

10/11/1851 REPORT

9/8

Rotary

9/15

10" @ 217'
Anhy 855
Drlg. 2260'

9/22

Lans 3018
Dat 3030-35
T.D. 3040
7" @ 3027
Rust

9/29

"
?

10/6

2000 acid
Testing.

10/13

1000 acid testing.

10/20

" , " "

10/27

Lans 3018
7" @ 3027
3000 acid
Pump 158 Pot.
T.D. 3040
Gravity 36.4

COMPLETED

OVER

1950

4/5

Lans. 3018'

7" @ 3027'

OTD 3040

Comp. 158 bbl

To drill deeper

5/17 TD 3269

Lans 3018

7" @ 3027

old TD 3040

Completed for 158 BOPD

COMPLETED

KANSAS

Map No. 72 Sec. 9 Twp. 14 R. 14W

Well No. 1 Harry Krug

Coralena Company

COMPLETED Contractor

SW NE SE

SECTION PLAT

990 Ft. from N. Line

_____ Ft. from S. Line

990 Ft. from E. Line

_____ Ft. from W. Line

Witt Pool

RECORD

Location _____

Cased _____ in., _____ ft.

Rig up _____

Sand _____

Drilling and Remarks:

Gas _____

Oil _____

Total Depth 3040

Lease 3018

7" @ 3027

3000 acid

Pump 158 BX

3 1/4 in

PRODUCTION

1st 24 hrs. Nat. _____

1st 24 hrs. after shot _____

Gas _____ Cu. Ft.

Dry Hole _____

Abandoned _____

Date

OCT 27 1943

19

S. J. LEWIS Scout

Kansas

OVIDD

Map No. _____ Sec. 9 Twp. 14 R. 14WWell No. 1 Harry Krug

_____ C R A _____ Company

_____ Contractor

SW NE SE **O. W. D. D**E1. 1851
SECTION PLAT990 Ft. from N. Line

_____ Ft. from S. Line

990 Ft. from E. Line

_____ Ft. from W. Line

FIRST REPORT

o

Russell County

Location _____

Rig up _____

Drilling and Remarks:

Lans. 3018

7" @ 3027

OTD 3040

Comp. 158 bbl.

to drill deeper

RECORD

Cased _____ in., _____ ft.

Sand _____

Gas _____ "

Oil _____ "

Total Depth _____

PRODUCTION

1st 24 hrs. Nat. _____

1st 24 hrs. after shot _____

Gas _____ Cu. Ft.

Dry Hole _____

Abandoned _____

Date

APR 5 1950 19J. E. TYRA

Scout


Well No. 1 Harry Krugh

C R A Company

Contractor

SW NE SE 1/4 El. 1851 SECTION PLAT

990 Ft. from N. Line

_____ Ft. from S. Line

990 Ft. from E. Line

_____ Ft. from W. Line

COMPLETE			
			0

OWDD

Russell

Location _____

Rig up _____

Drilling and Remarks:

*Lens 3018
7' @ 3027
old T.D. 3040
Completed for
158 BOPD*

RECORD

Cased _____ in., _____ ft.

Sand _____

Gas _____

Oil _____

Total Depth 3269

PRODUCTION

1st 24 hrs. Nat. _____

1st 24 hrs. after shot _____

Gas _____ Cu. Ft.

Dry Hole _____

Abandoned _____

Date

MAY 17 1950

19

J. E. TYRA Scout

