

KANSAS


FORM 51 5M 1-42 PETROL

Russell

Section 9 Township 14 Range 14-W

Well No. #2 Albert

Company Coralena

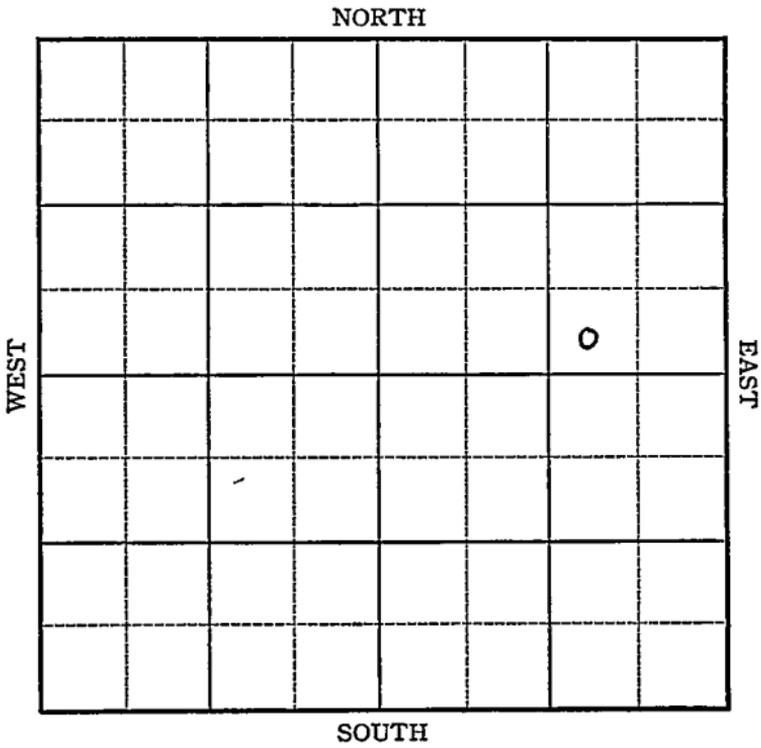


Sec. 9 Twp. 14 R. 14-W

Well No. #2 Albert Farm

Coralena Company

_____ Ft. from N. Line
330 Ft. from S. Line
990 Ft. from E. Line
 _____ Ft. from W. Line
slav. 1856

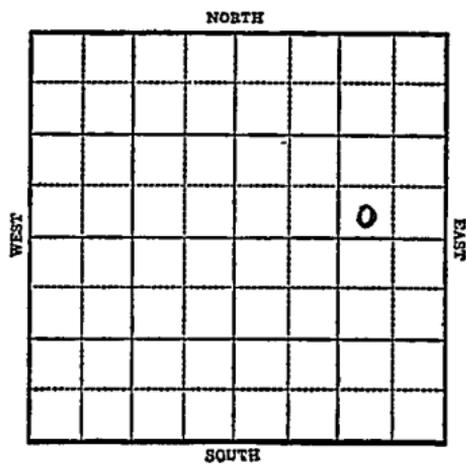

1943

R E P O R T

- 8/11 10" @ 152'
Drlg. 1700'
- 8/18 Topeka 2728
Drlg. 3000
- 8/25 Lans 3016-42 T.D.
7" @ 3024'
Rust
- 9/1 "
- 9/8 600" oil in 12 hrs.
- 9/15 2000 acid
Temp. Pot. 156 Pump
- 9/22 Lans 3016
7" @ 3024
2000 acid
Pump 1025 Pot.
Gravity 39.7
T.D. 3042'

COMPLETED

KANSAS

Map No. 72 Sec. 9 Twp. 14 R. 14W

Well No. 2 Albert

Coralena Company

FIRST REPORT Contractor

SW SE NE

SECTION PLAT

_____ Ft. from N. Line

330 Ft. from S. Line

990 Ft. from E. Line

_____ Ft. from W. Line

WTTT POOL.

Location _____

Rig up _____

Drilling and Remarks:

10" - 152'

Drlg. 1700'

RECORD

Cased _____ in., _____ ft.

Sand _____

Gas _____

Oil _____

Total Depth _____

PRODUCTION

1st 24 hrs. Nat. _____

1st 24 hrs. after shot _____

Gas _____ Cu. Ft.

Dry Hole _____

Abandoned _____

Date

AUG 11 1943

19

S. J. LEWIS

Scout

KANSAS

Map No. 72 Sec. 9 Twp. 14 R. 14W

Well No. 2 Albert

Coralene Company

COMPLETED Contractor

SW SE NE

_____ Ft. from N. Line

330 Ft. from S. Line

990 Ft. from E. Line

_____ Ft. from W. Line

SECTION PLAT

Witt Pool

Location _____

Rig up _____

Drilling and Remarks:

*Loc 3016
7" @ 3024
2000 Acid
Pump 1025 Pst*

39 2/3

RECORD

Cased _____ in., _____ ft.

Sand _____

Gas _____

Oil _____

Total Depth 3042

PRODUCTION

1st 24 hrs. Nat. _____

1st 24 hrs. after shot _____

Gas _____ Cu. Ft.

Dry Hole _____

Abandoned _____

Date

SEP 22 1943 19

S. J. LEWIS Scout