


Section 9 Township 14 Range 14W

Well No. #6 Albert Krug

Company C R A

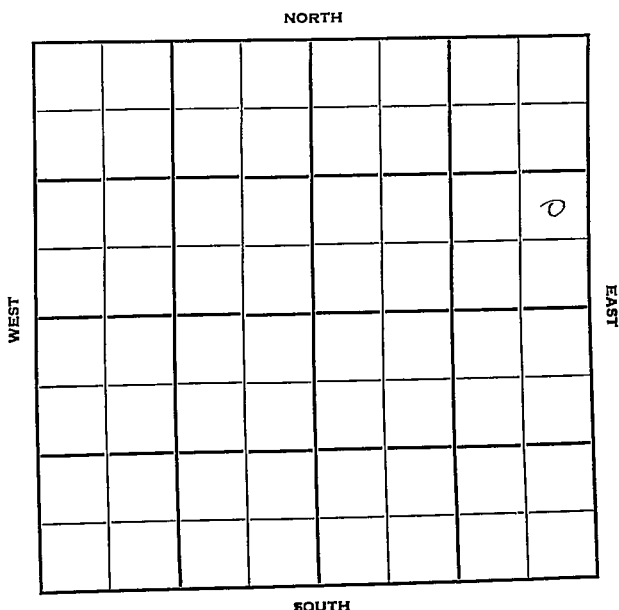

Sec. 9 Twp. 14 R. 14W

Well No. #6 Albert Krug Farm

C R A

Company

C R A

Contractor

Hall-Gurney

Ft. from N. Line

990'


Ft. from S. Line

330'

Ft. from E. Line

Ft. from W. Line

NE SE NE

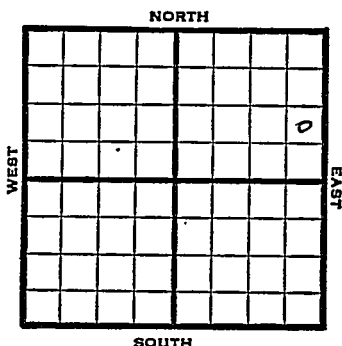

1950

Elev 1849

REPORT

3/29

RUR

5/17

TD 3266

8 5/8" @ 851

Tonkio 2442

Tppeka 2707

Heeb 2934

Lans 2999

Reagen 3260-66

5" @ 3261

P54 BOPD


Completed

COMPLETED

Map No. _____ Sec. 9 Twp. 14 R. 14WWell No. 6 Albert Krug_____
C R A _____ Company_____
C R A _____ Contractor

NE SE NE

SECTION PLAT

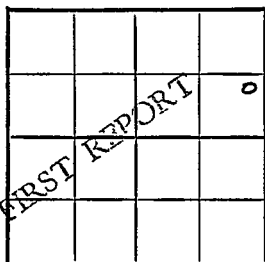Ft. from N. Line990
Ft. from S. Line330
Ft. from E. Line_____
Ft. from W. LineRussell County

Location _____

Rig up _____

Drilling and Remarks:

R U R

RECORD

Cased _____ in., _____ ft.

Sand _____

Gas _____

Oil _____

Total Depth _____

PRODUCTION

1st 24 hrs. Nat. _____

1st 24 hrs. after shot _____

Gas _____ Cu. Ft.

Dry Hole _____

Abandoned _____

Date

MAR 29 195019J. E. TYRAScout

Kansas

Map No. _____ Sec. 9 Twp. 14 R. 14WWell No. 6 Albert Krug

C R A

Company

Contractor

NE SE NE

E1. 1849

SECTION PLAT

COMPLETE			
			0

_____ Ft. from N. Line

990 Ft. from S. Line330 Ft. from E. Line

_____ Ft. from W. Line

Russell

Location _____

Rig up _____

Drilling and Remarks:

85' @ 851
 Forkio 2442
 Jopka 2707
 Hub 2934
 Lens 2999
 Reagen 3260-66

Date

5' @ 3261

RECORD

Cased _____ in., _____ ft.

Sand _____

Gas _____

Oil _____

Total Depth 3266

PRODUCTION

1st 24 hrs. Nat. _____

1st 24 hrs. after shot _____

Gas _____ Cu. Ft.

Dry Hole _____

Abandoned _____

P54 BOPD.

MAY 17 1950

19

G. E. TYRA Scout