

~~KANSAS~~

Russell

FORM 51 25M 3-49 PETROL

Section 9 Township 14 Range 14-W

Well No. #2 H Krug

Company G R A

NORTH

9

WEST

							0

EAST

SOUTH

Russell

KANSAS

Sec. 9 Twp. 14 R. 14W ✓

Well No. #2 H. Krug Farm \_\_\_\_\_

C R A

Company \_\_\_\_\_


Witt Pool

330' Ft. from N. Line

\_\_\_\_\_ Ft. from S. Line

330' Ft. from E. Line

\_\_\_\_\_ Ft. from W. Line  
NE NE SE

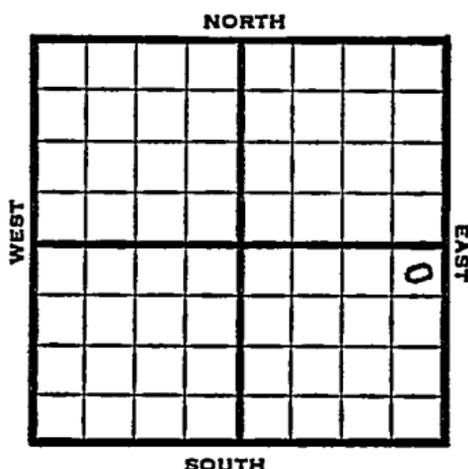

1950

Elev 1849' REPORT

1/11  
3/8

MIM  
TD 3261'  
8 5/8" set 855'  
5 1/2" set 3353'  
Lans 2998'  
Regan Sd 3256'  
23 BOPD  
552 BOPD  
Comp

**COMPLETED**

Kansas

Witt Pool

Map No. \_\_\_\_\_ Sec. 9 Twp. 14 R. 14W

Well No. 2 H. Krug

C R A

Company

Contractor

NE NE SE

## SECTION PLAT

330 Ft. from N. Line

\_\_\_\_\_ Ft. from S. Line

330 Ft. from E. Line

\_\_\_\_\_ Ft. from W. Line

<del>FIRST REPORT</del>			
			0

Russell County

Location \_\_\_\_\_

Rig up \_\_\_\_\_

Drilling and Remarks:

M I M

## RECORD

Cased \_\_\_\_\_ in., \_\_\_\_\_ ft.

Sand \_\_\_\_\_

Gas \_\_\_\_\_

Oil \_\_\_\_\_

Total Depth \_\_\_\_\_

## PRODUCTION

1st 24 hrs. Nat. \_\_\_\_\_

1st 24 hrs. after shot \_\_\_\_\_

Gas \_\_\_\_\_ Cu. Ft.

Dry Hole \_\_\_\_\_

Abandoned \_\_\_\_\_

Date

JAN 11 1950 19

J. E. TYRA Scout

Map No. \_\_\_\_\_ Sec. 9 Twp. 14 R. 14W

Well No. 2 H. Krug

C R A

Company

Contractor

NE N<sup>r</sup> SE

*EI. 1849*  
SECTION PLAT

330 Ft. from N. Line

\_\_\_\_\_ Ft. from S. Line

330 Ft. from E. Line

\_\_\_\_\_ Ft. from W. Line

Russell County

COMPLETE			
			o

Location \_\_\_\_\_

Rig up \_\_\_\_\_

Drilling and Remarks:

*8 5/8 @ 855*  
*5 1/2 @ 3353*  
*Lane 2998*  
*Regan sd. 3256*  
*23 BOPD*  
*552 BOPD*

RECORD

Cased \_\_\_\_\_ in., \_\_\_\_\_ ft.

Sand \_\_\_\_\_

Gas \_\_\_\_\_

Oil \_\_\_\_\_

Total Depth 3261

PRODUCTION

1st 24 hrs. Nat. \_\_\_\_\_

1st 24 hrs. after shot \_\_\_\_\_

Gas \_\_\_\_\_ Cu. Ft.

Dry Hole \_\_\_\_\_

Abandoned \_\_\_\_\_

Date

*C*  
MAR 8 1950

J. E. TYRA