

KANSAS

Ellsworth


Section 4 Township 16 Range 10WWell No. 2 Skalicky SWDCompany Magnolia

Stoltenberg Pool

NORTH

WEST

EAST

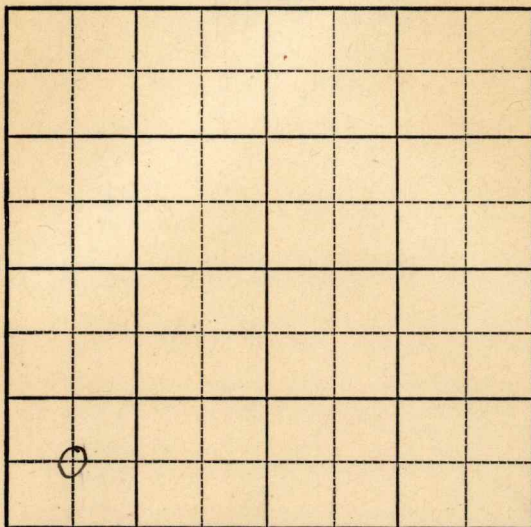

SOUTH

KANSAS

Ellsworth

Sec. 4 Twp. 16 R. 10W

Well No. #2 Skalicky SWD Farm

Magnolia Company

Stoltenberg Pool


 Ft. from N. Line

660' Ft. from S. Line

 Ft. from E. Line

660' Ft. from W. Line

C SW SW

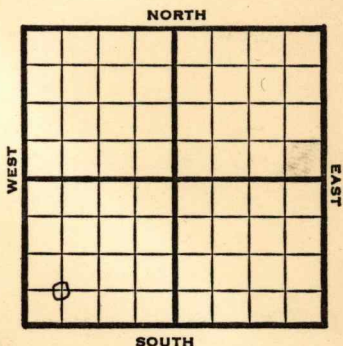

1948

Elev. 1759' REPORT

9/8 Location

9/14 10"@ 352

WOC

9/21 Drlg 2785'

9/29 TD 3574-

7"@ 3340'

10/6 "

10/13 Drlg 3747'

10/19 TD 3886'

10/26 "

11/3 "

11/10 "

11/17 Arb. 3269'

7" @ 3340'

SWD

TD 3886'

ABANDONED

Ellsworth County Kansas State

Map No. _____ Sec. 4 Twp. 16 R. 10W


Well No. 2 Skalicky SWD

Magnolia Company

FIRST REPORT Contractor

C SW SW

SECTION PLAT

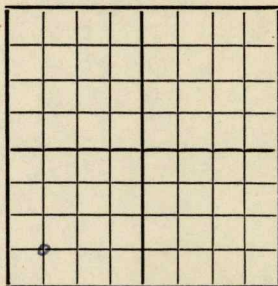

_____ Ft. from N. Line

660 Ft. from S. Line

_____ Ft. from E. Line

660 Ft. from W. Line

Stoltenberg Pool

Remarks:

Location

Date
SEP 8 1948

Scout
S. J. LEWIS

Map No. 55 Sec. 4 Twp. 16 R. 10W

Well No. 2 Skalicky SWD

Magnolia

Company

ABANDONED

Contractor

C SW SW

E11259

SECTION PLAT

Ft. from N. Line

660

Ft. from S. Line

Ft. from E. Line

660

Ft. from W. Line

4			

Ellsworth County

Location

Rig up

Drilling and Remarks:

Cr 83268

7" CQ 340

SWD

RECORD

Cased _____ in., _____ ft.

Sand _____

Gas _____

Oil _____

Total Depth 3886

PRODUCTION

1st 24 hrs. Nat. _____

1st 24 hrs. after shot _____

Gas _____ Cu. Ft.

Dry Hole _____

Abandoned _____

Date

NOV 17 1948 19

S. J. LEWIS

Scout