


DX 78-1

Section 4 Township 16 Range 10W

Well No. 3 Borecky

Company Henderson Oil

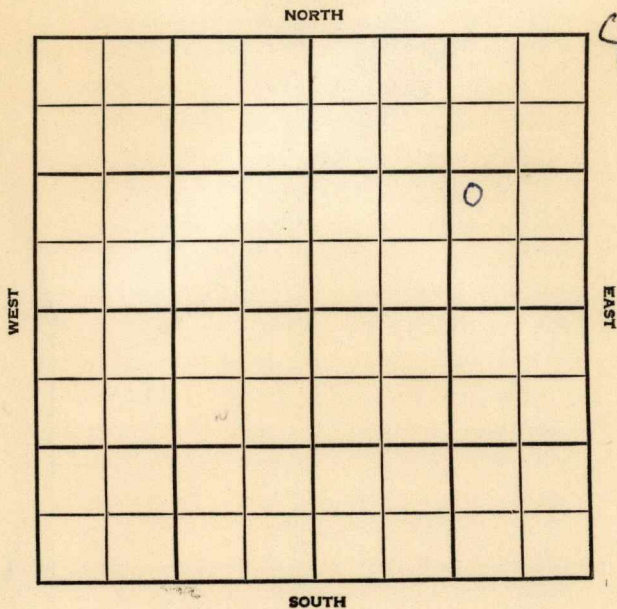

Ellsworth

IN VAS

SEC. 4	TWP. 16	R. 10W
-----------	------------	-----------


WELL NO. #3 Borecky FARM

COMPANY Henderson Oil

CONTRACTOR Todd Drlg

NW Progress

_____ Ft. from N. Line
 _____ Ft. from S. Line
 _____ Ft. from E. Line
 _____ Ft. from W. Line

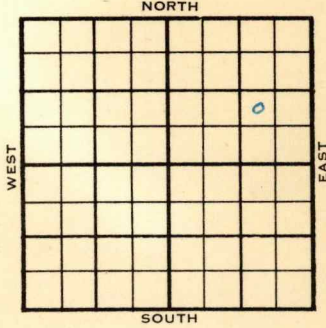

NW SE NE

	ELEVATION	REPORT
--	-----------	--------

1955

1820'

7/27

RUR

9-14

Comm. 7-24-55
 8" 355;
 DST 3358-66 op 1 hr. rec. 600⁰ oil
 1060#;
 RTD 3366;
 5" 3359 w/75;
 CO 3366; swb 10 boph no wtr. 4 hrs.;
 Phy. pmp 183 bopd no wtr.

TOPS	DEPTH
H.	2852
Dg.	2882
B.L.	2954
L.	2973
B.K.C.	3255
C.	3287
Sd	3339
A	3358

COMPLETED

County Ellsworth Elev. _____
 Sec. 4 Twp. 16 Rge. 10W
 Company Henderson Oil
 Farm Name Borecky No. 3

TOPS	DEPTH	LOG	DATUM	Loc. in Sec.
Anh.				NW SE NE
Tp.				
H.				
Tr.				
Dg.				
Bl.				
L.				Geol. _____
K.C.				Contr. _____
B.K.C.				Todd Drlg.
Ce.				
C.				Pool
M.				NW Progress
M.				
K.				
Mz.				
Ma.				
V.				
S.				
S.				
A.				
R.				
Pe.				
G.				
T.D.				

FIRST REPORT
 JUL 27 1955

Date Comm. RUR

15

Co.
 Lse.
 No.
 Sec.
 T.
 R.

County Ellsworth Elev. 1820
 Sec. 4 Twp. 16S Rge. 10W
 Company Henderson Oil
 Farm Name Borecky No. 3

Co.

TOPS	DEPTH	LOG	DATUM	Loc. in Sec.																		
Anh.				NW SE NE																		
TP.																						
H.	2852		1032																			
Tr.																						
Dg.	2882		1062																			
BL.	2954		1134																			
L.	2973		1153																			
K.C.				Geol.																		
B.K.C.	3255		1435	Contr.																		
Ce.				Todd Drlg.																		
C.	3287		1467																			
M.				Pool																		
M.				NW Progress																		
K.																						
Mz.																						
Mq.																						
V.																						
Sd	3339		1519	<table border="1"> <tr><td></td><td></td><td></td></tr> <tr><td></td><td></td><td></td></tr> <tr><td></td><td></td><td></td></tr> <tr><td></td><td></td><td></td></tr> <tr><td></td><td></td><td></td></tr> <tr><td></td><td></td><td></td></tr> </table>																		
S.																						
A	3358		1538	COMPLETE																		
R.																						
Pe.																						
G.																						
T.D.																						

Use.

No.

Date Comm. 7-24-55 SEP 14 1955

Sec.

8" 355; DST 3358-66 op 1 hr. rec. 600'
 oil 1060#; RTD 3366; 5" 3359 w/75;
 CO 3366; swb 10 boph no wtr. 4 hrs.;
 Phy. pmp 183 bopd no wtr.

T.

R.