


Ellsworth

KANSAS 10W

SECTION 4 TOWNSHIP 16 RANGE 10W

WELL NO. #3 Sebesta

COMPANY Grant Oil

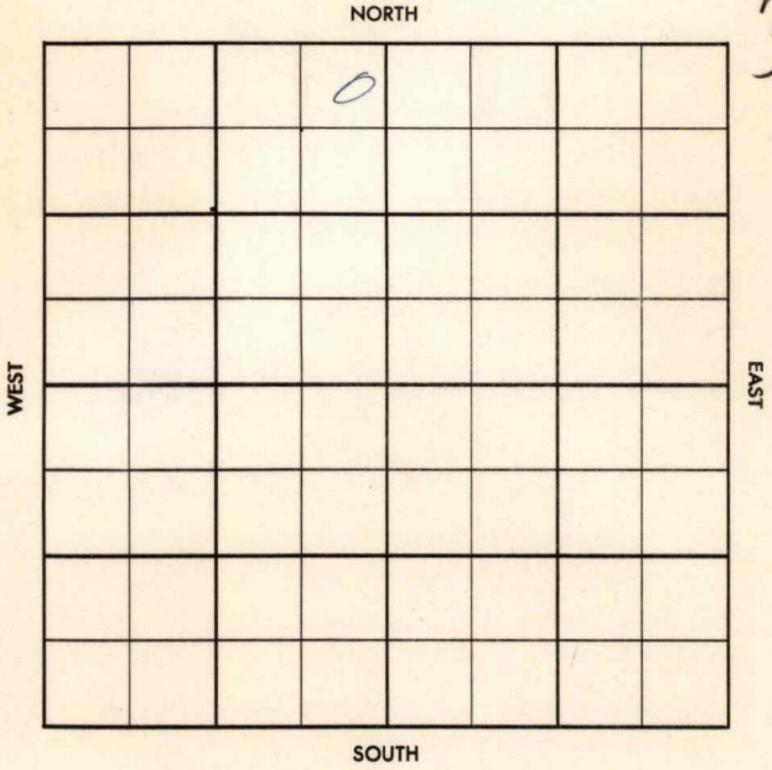


SEC. 4	TWP. 16	R. 10W
-----------	------------	-----------

WELL NO. #3 Sebesta FARM

COMPANY Grant Oil

CONTRACTOR B & B Drlg.

NW Progress
 380 Ft. from N. Line
 _____ Ft. from S. Line
 226 Ft. from E. Line
 _____ Ft. from W. Line

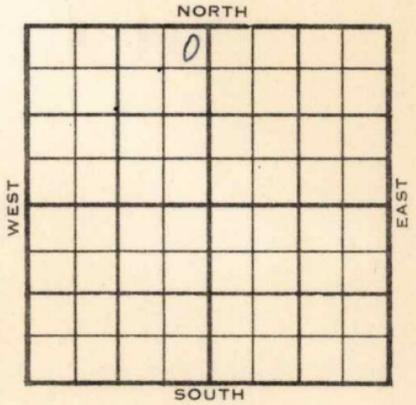

NE NE NW

1956	ELEVATION 1720 DF, 1723 RB	REPORT
------	-------------------------------	--------

3-28 Comm. 3-25-56
 ## 8" @ 276
 Drlg. 1758

4-11 DST 3284-86 op 1 hr. rec. 10' mud,
 900/20"
 5 1/2" @ 3284 w/100
 DD-3302
 Temp. abandoned
 H. 2754
 Tr. 2772
 BL. 2854
 L. 2871
 C. 3208
 S. Sh. 3256
 A. 3283
 TD 3286 1/2'

ABANDONED

County **Ellsworth** Elev. _____
 Sec. **4** Twp. **16** Rge. **10W**
 Company **Grant Oil**
 Farm Name **Sebesta** No. **3**

TOPS	DEPTH	LOG	DATUM	Loc. in Sec.
Anh.				NE NE NW
TP.				380' NL
H.				226' EL
Tr.				
Dg.				
Bl.				
L.				Geol.
K.C.				Contr.
B.K.C.				B & B Drlg.
Ce.				
C.				
M.				Pool
M.				NW Progress
K.				
Mz.				
Ma.				
V.				
S.				
S.				
A.				FIRST REPORT
R.				
Pe.				
G.				MAR 28 '56
T.D.				

Date Comm. **3-25-56**
8" @ 276 drlg. 1758

(Large red and blue scribbles)

Co.
Lse.
No.
Sec.
T.
R.

County Ellsworth Elev. 1720 DF
1723 RB
 Sec. 4 Twp. 16 Rgs. LOW
 Company Grant Oil
 Farm Name Sebesta No. 3

TOPS	DEPTH	LOG	DATUM	Loc. in Sec.
Anh.				NE NE NW
Tr.				380' NL
Dg.				226' EL
Bl.	<u>2854</u>		<u>1134</u>	
L.	<u>2871</u>		<u>1151</u>	
K.C.				Geol.
B.K.C.				Contr.
Ce.				
C.	<u>3208</u>		<u>1488</u>	B & B
M.				Pool
M.				NW Progress
K.				
Mz.				
Mq.				
V.				
S. <u>56</u>	<u>3256</u>		<u>1536</u>	<div style="border: 1px dashed black; padding: 5px; text-align: center;"> 0 ABANDONED </div>
S.				
A.	<u>3283</u>		<u>1563</u>	
R.				
Pe.				
G.				
T.D.	<u>3286 1/2</u>			

Date Comm. 3-25-56 APR 11 1956
8" @ 276 DST 3284-86 open 1 hr.
rec. 10' mud 900/20" 5 1/2" @ 3284/100
DD 3302 Temp. abd.