


SECTION 4 TOWNSHIP 16 RANGE 10W

WELL NO. #4 Sebesta

COMPANY Grant Oil

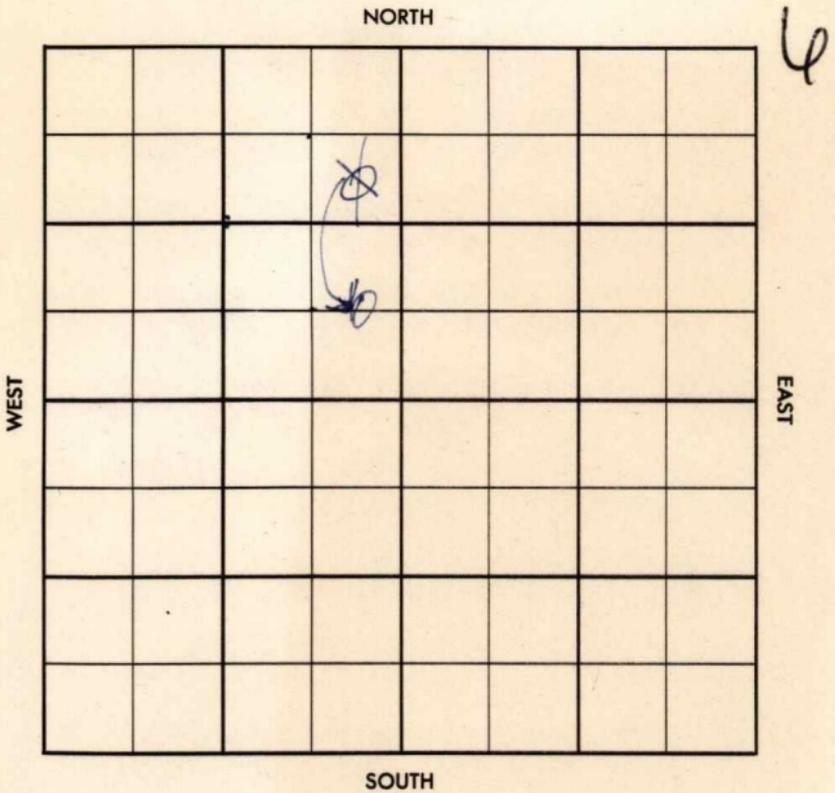

Ellsworth **KANSAS**

SEC. 4	TWP. 16	R. LOW
-----------	------------	-----------


WELL NO. FARM
#4 Sebesta

COMPANY
Grant Oil

CONTRACTOR
B & B

NW Progress

_____ Ft. from N. Line
_____ Ft. from S. Line
_____ Ft. from E. Line
_____ Ft. from W. Line

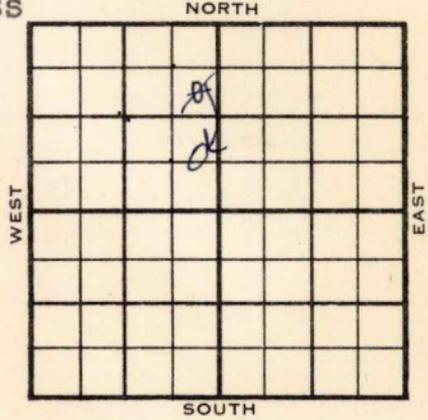

~~SE NE NW~~
E/2 SE NW

	ELEVATION	REPORT
1956	1726'	

4-4 MIR

5-16 Spud 4-3-56
 8 5/8" @ 261
 DST 3276-80 op 1 hr. rec. 100' oil,
 BHP 1110
 5 1/2" @ 3276
 CO 3280
 B/ 3 BO, no/wtr., 1 hr.
 P/ 105 BOPD, no/wtr.
 H. 2763', Tr. 2782', BL. 2863',
 L. 2880', C. 3208', S.Sd. 3254',
 A. 3275',
 TD 3280'.

COMPLETED

~~CORRECTION~~

FORM 513 SUNRAY

County Ellsworth Elev. 1726
Sec. 4 Twp. 16 Rge. 10W
Company Grant Oil
Farm Name Sebesta No. 4

TOPS	DEPTH	LOG	DATUM	Loc. in Sec.
Anh.				### E2SE NW
Tp.				
H.	2763			
Tr.	2782			
Dg.				
Bl.	2863			
L.	2880			
K.C.				Geol.
B.K.C.				Contr.
Ce.				
C.	3208			B & B
M.				
M.				Pool
K.				NW Progress
Mz.				
Ma.				
V.				
S.	sd 3254			X o COMPLETE
S.				
A.	3275			
R.				
PE.				
G.				
TD.	3280			

Date Comm. MAY 16 1956

MITR APR 11 '56 4-3-56 878 261
3170 APR 18 '56 DST 3276-80 1hr
see 100' oil BHP 1110 5 1/2 @
3276 MITR Co 3280 # 3 B0
no/w 1hr POP APR 25 '56 MAY 2 '56
MAY 9 '56 v MAY 16 '56 Ph P. 105 B0 pd
no/w tr

County Ellsworth Elev. _____
 Sec. 4 Twp. 16 Rge. LOW
 Company Grant Oil
 Farm Name Sebesta No. 4

TOPS	DEPTH	LOG	DATUM	Loc. in Sec.																														
Anh.				SE NE NW																														
Tr.																																		
Dg.																																		
Bl.																																		
L.				Geol. _____																														
K.C.				Contr. _____																														
B.K.C.																																		
Ce.				<u>B & B</u>																														
C.																																		
M.				Pool																														
M.				<u>NW Progress</u>																														
K.				<table border="1"> <tr> <td></td> <td></td> <td></td> </tr> </table>																														
Mz.																																		
Me.																																		
V.																																		
S.																																		
S.																																		
A.																																		
R.																																		
Pe.																																		
G.																																		
T.D.																																		

Date Comm. M I R

APR 1 1956
R.G.

Co.

Loc.

No.

Sec.

T.

R.