

KANSAS


FORM 51 5M PETROL

Russell

Section 9 Township 14 Range 14 ~~W~~

Well No. #2 Rusch

Company Texas

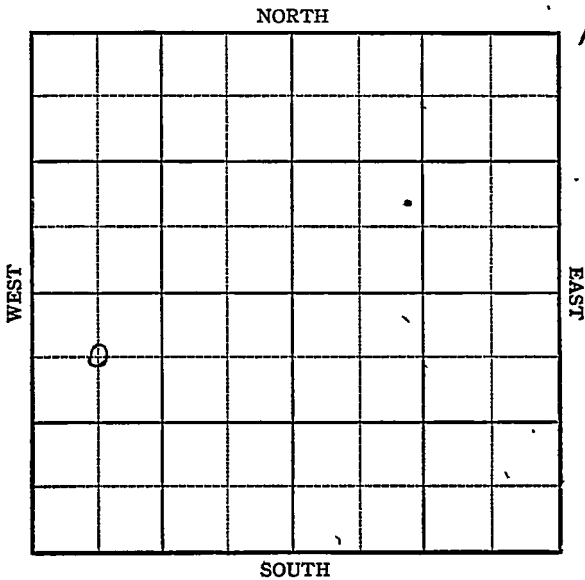

KANSAS

Sec. 9 Twp. 14 R. 14-W

Well No. #2 Rusch Farm


Texas Company

660 Ft. from N. Line

 Ft. from S. Line

 Ft. from E. Line

660 Ft. from W. Line

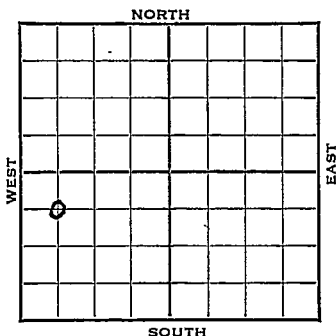

1943 *Elv. 1871* REPORT

8/25 Drlg. 375' To run casing.

9/1 10" @ 375'
Drlg. 1825'

9/8 Lans 3044
SO 3070-74 T.D.
7" @ 3054
" ust.

9/15 "

9/22 Lans 3044
7" @ 3054
4000 acid
Pump 123 Pot.
Gravity 39.9
T.D. 3086'

COMPLETED

KANSAS

Map No. 72 Sec. 9 Twp. 14 R. 14W

Well No. 2 Rusch

~~Texas~~ _____ Company

FIRST REPORT

Contractor

C NW SW

SECTION PLAT

660 Ft. from N. Line

_____ Ft. from S. Line

_____ Ft. from E. Line

660 Ft. from W. Line

o			

Witt Pool

Location _____

Rig up _____

Drilling and Remarks:

**Drlg. 375
to run casing**

RECORD

Cased _____ in., _____ ft.

Sand _____

Gas _____

Oil _____

Total Depth _____

PRODUCTION

1st 24 hrs. Nat. _____

1st 24 hrs. after shot _____

Gas _____ Cu. Ft.

Dry Hole _____

Abandoned _____

Date

AUG 25 1943

19

S. J. LEWIS

Scout

KANSAS

Map No. 72 Sec. 9 Twp. 14 R. 14W

Well No. 2 Rusch

Texas Company

COMPLETED Contractor

C NW SW

SECTION PLAT

660 Ft. from N. Line

_____ Ft. from S. Line

_____ Ft. from E. Line

660 Ft. from W. Line

o			

Witt Pool

Location _____

Rig up _____

Drilling and Remarks:

*Lean 3044
7" @ 3057
4000 rods
Pump 128 P.S.*

392 G

RECORD

Cased _____ in., _____ ft.

Sand _____

Gas _____

Oil _____

Total Depth 3086

PRODUCTION

1st 24 hrs. Nat. _____

1st 24 hrs. after shot _____

Gas _____ Cu. Ft.

Dry Hole _____

Abandoned _____

Date

SEP 22 1943 19

S. J. LEWIS Scout