


SECTION 4 TOWNSHIP 16 RANGE 10 W

WELL NO. #7 Borecky

COMPANY Henderson Oil

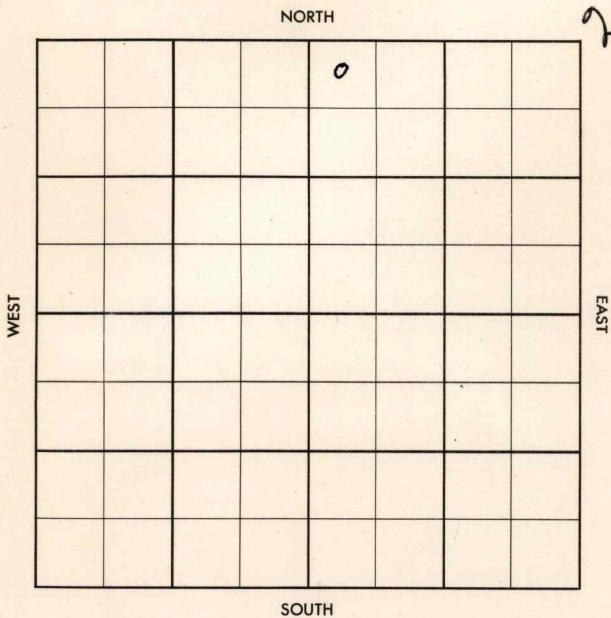

Ellsworth

KANSAS


SEC.	TWP.	R.
4	16	10W

WELL NO. #7 Borecky FARM

COMPANY Henderson Oil

CONTRACTOR Lewis Progress

_____ Ft. from N. Line
 _____ Ft. from S. Line
 _____ Ft. from E. Line
 _____ Ft. from W. Line

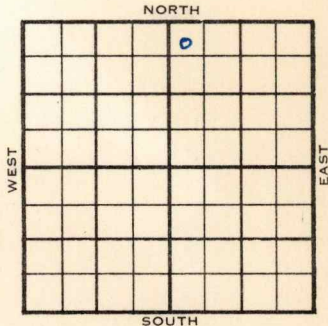

NW N W NE

1955 ELEVATION 1735 DB, 1732 DF REPORT

10/19 Comm 10-16-55
 8" @ 325/200
 Drlg 1380

12-14 DST 3277-82 op 1 hr. rec. 15' ocm, 590#
 DST 3279-86 op 1 hr. rec. 45' ocm, 740#
 DST 3282-93 op 1 hr. rec. 60' ocm, 750#
 DST 3290-3310 op 25 min., rec 15' mud,
 940#
 5 1/2" @ 3383
 CO to 3320, 24/ 3280-88, 1500 A
 S/ 2 boph,
 P/ 36 bopd, 20 BW
 Comp. 36 bopd - 35% wtr.
 H. 2764
 BL 2866
 L. 2887
 BKC 3174
 C. 3208
 A. 3277
 TD 3735'

COMPLETED

1735 KB
1732 DF

County **Ellsworth**

Elev.

Sec. **4**

Twp. **16**

Rge. **10W**

Company **Henderson Oil**

Farm Name **Borecky**

No. **7**

TOPS	DEPTH	LOG	DATUM
Anh.			
Tp.			
H.	2764		1032
Tr.			
Dg.			
Bl.	2866		1134
L.	2887		1154
K.C.			
B.K.C.	3174		1442
Ce.			
C.	3208		1476
M.			
M.			
K.			
Mz.			
Mq.			
V.			
S.			
S.			
A	3277		1545
R.			
Pe.			
G.			
T.D.	3735		

Loc. in Sec.

NW NW NE

Geol.

Contr.

Lewis

Pool

Progress

		0	
COMPLETE			

Date Comm. **10-16-55**

DEC 14 1955

8" @ 325/200 DST 3277-82 open 1 hr.

rec. 15' ocm 590# DST 3279-86

open 1 hr. rec. 45' ocm 740#

DST 3282-93 open 1 hr. rec. 60' ocm

750# DST 3290-3310 open 25 min.

Rec. 15' mud 940# 5 1/2" @ 3383

CO to 3320 24/ 3280-88 1500 A

S/ 2 boph P/ 36 bopd 20 bw

Comp. 36 bopd 35% wtr.