


Section 4 Township 16 Range 10 W

Well No. #8 Borecky

Company Henderson Oil

2

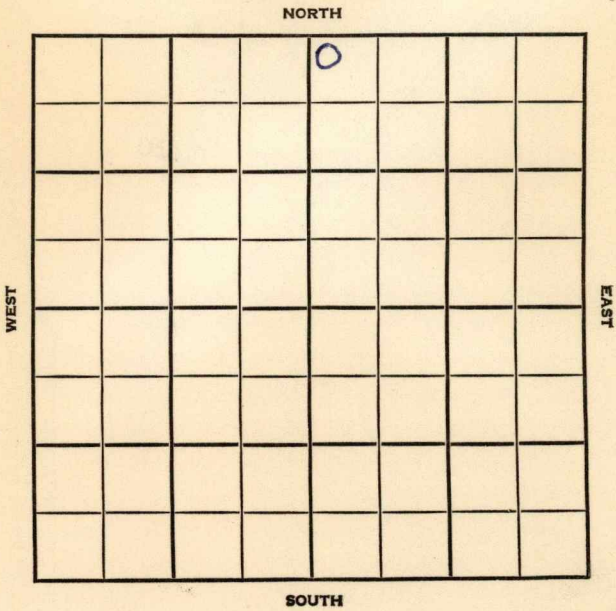

SEC. 4	TWP. 16	R. 10W
-----------	------------	-----------

WELL NO. #8 Borecky FARM

COMPANY Henderson Oil

CONTRACTOR Lewis Drlg.


NW Progress

149' Ft. from N. Line

Ft. from S. Line

49 Ft. from E. Line

Ft. from W. Line

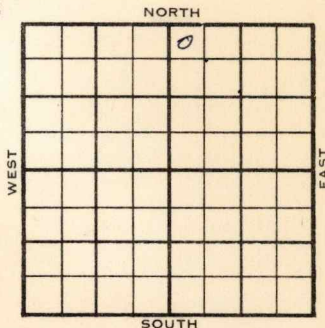

NW NW NE

1956	ELEVATION 1720 RB	REPORT
------	----------------------	--------

~~###~~

2-15 Comm. 2-13-56
8" @ 328/225
Drlg. 514

4-11 5½" @ 3356
DD 3365
FU 4500' oil,
S/ 148 bo, 90 min,
Comp. 318 bopd, 15% wtr.
H. 2751
Tr. 2770
Dg. 2779
Bl. 2846
L. 2866
BKC 3156
S. 3238-48
A. 3260
TD 3357

COMPLETED

County Ellsworth Elev. _____
 Sec. 4 Twp. 16 Rge. 10W
 Company Henderson Oil
 Farm Name Borecky No. 8

TOPS	DEPTH	LOG	DATUM	Loc. in Sec.
Anh.				NW NW NE
T.P.				149' NL
H.				49' WL
Tr.				
Dg.				
B.L.				
L.				Geol. _____
K.C.				Contr. _____
B.K.C.				
Ce.				Lewis Drlg.
C.				
M.				Pool
M.				N W Progress
K.				
Mz.				
Ma.				
V.				
S.				
S.				
A.				
R.				
Pe.				
G.				
T.D.				

		0	
FIRST REPORT			
		FEB 15	56

Date Comm. 2-13-56
8" @ 228/225 drlg. 514

[Handwritten signature]

Co.
Lse.
No.
Sec.
T.
R.

County Ellsworth Elev. 1720 RB
 Sec. 4 Twp. 16 Rge. 10W
 Company Henderson Oil
 Farm Name Borecky No. 8

TOPS	DEPTH	LOG	DATUM	Loc. in Sec.
Anh.				NW NW NE
TP.				
H.	<u>2751</u>			<u>149'</u> NL
Tr.	<u>2770</u>			<u>49'</u> WL
Dg.	<u>2779</u>			
Bl.	<u>2846</u>			
L.	<u>2866</u>		<u>1146</u>	Geol.
K.C.				Contr.
B.K.C.	<u>3156</u>		<u>1436</u>	Lewis
Ce.				Pool
C.				NW Progress
M.				<div style="border: 1px dashed black; padding: 5px; display: flex; align-items: center; justify-content: center;"> 0 <div style="border: 1px solid black; padding: 5px;"> <p style="margin: 0;">COMPLETE</p> </div> </div>
M.				
K.				
Mz.				
V.				
S.	<u>3238-48</u>		<u>1518</u>	
S.				
A.	<u>3260</u>		<u>1540</u>	
R.				
PE.				
G.				
TD.	<u>3357</u>			

Date Comm. 2-13-56 APR 1 1 1956

8" @ 328/225 5¹/₂" @ 3356 DD 3365

FU 4500' oil S/ 148 bo 90 min.

Comp. 318 bopd 15% wtr.

Co. Lse. No. Sec. T. R.