

Ellsworth


KANSAS

FORM 51 5M PETROL

Section 5 Township 16 Range 10-W

Well No. #1 Adamek

Company Sohio et al

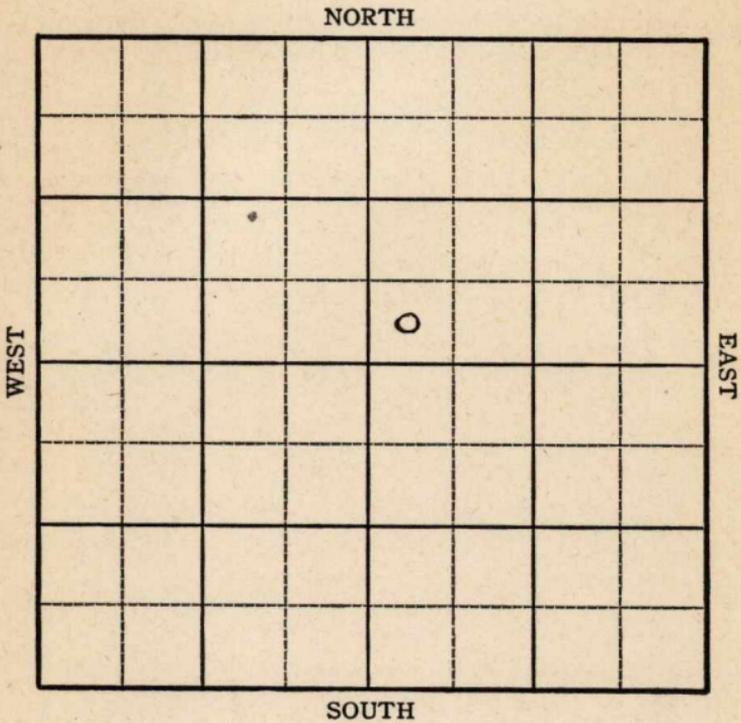

Sec. 5 Twp. 16 R. 10W

Well No. #1 Adamek Farm

Sohio et al Company

Bloomer


           Ft. from N. Line

330 Ft. from S. Line

           Ft. from E. Line

330 Ft. from W. Line

SW NE

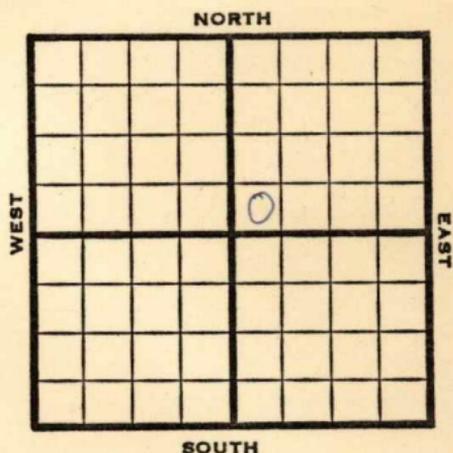

1946

**Elev. 1838**

REPORT

3/13

RUR

3/21

8" - 315' WOC.

3/28

Drig. 3040'

4/4

**Lans. 2996**

**Simp 3308**

**Arb. 3312**

5" @ 3312

TD 3318

500 acid.

Swb. 35 oil per hr. 4 hrs.

4/10

**Arb. 3312**

5" @ 3312

500 acid.

TD 3318

Echo Pot. 796

Grav. 42.0

**COMPLETED**

**KANSAS**

Kansas Pool Name Bloomer

Map No. 55 Sec. 5 Twp. 16 R. 10W

Well No. 1 Adamak

Sohio etal. Company

FIRST REPORT Contractor

SW NE


SECTION PLAT

\_\_\_\_\_ Ft. from N. Line

330 Ft. from S. Line

\_\_\_\_\_ Ft. from E. Line

330 Ft. from W. Line

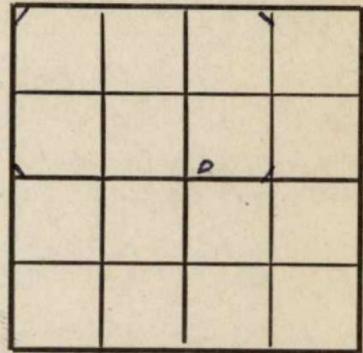

Ellsworth County

Location \_\_\_\_\_

Rig up \_\_\_\_\_

Drilling and Remarks:

R U R

**RECORD**

Cased \_\_\_\_\_ in., \_\_\_\_\_ ft.

Sand \_\_\_\_\_

Gas \_\_\_\_\_

Oil \_\_\_\_\_

Total Depth \_\_\_\_\_

**PRODUCTION**

1st 24 hrs. Nat. \_\_\_\_\_

1st 24 hrs. after shot \_\_\_\_\_

Gas \_\_\_\_\_ Cu. Ft.

Dry Hole \_\_\_\_\_

Abandoned \_\_\_\_\_

Date

MAR 13 1946 19

S. J. LEWIS Scout

**KANSAS**

Kansas Pool Name Bloomer

Map No. 55 Sec. 5 Twp. 16 R. 10W

Well No. 1 Adamek

Sohio etal. Company

**COMPLETED**

Contractor

NW NE

*E 11838*  
**SECTION PLAT**

		0	

\_\_\_\_\_ Ft. from N. Line

330 Ft. from S. Line

\_\_\_\_\_ Ft. from E. Line

330 Ft. from W. Line

Ellsworth County

Location \_\_\_\_\_

Rig up \_\_\_\_\_

Drilling and Remarks:

*Core 7 33 1/2*  
*5" 23 1/2*  
*500 acid*  
*Ech 10 28 796*

*42 0/80*

**RECORD**

Cased \_\_\_\_\_ in., \_\_\_\_\_ ft.

Sand \_\_\_\_\_

Gas \_\_\_\_\_

Oil \_\_\_\_\_

Total Depth 338

**PRODUCTION**

1st 24 hrs. Nat. \_\_\_\_\_

1st 24 hrs. after shot \_\_\_\_\_

Gas \_\_\_\_\_ Cu. Ft.

Dry Hole \_\_\_\_\_

Abandoned \_\_\_\_\_

Date

APR 10 1946 19

S. J. LEWIS Scout