

Section 5 Township 16 Range 10-W

Well No. #1 Adamek

Company Skelly Oil


NORTH


Stoltenberg Pool

WEST

EAST

SOUTH

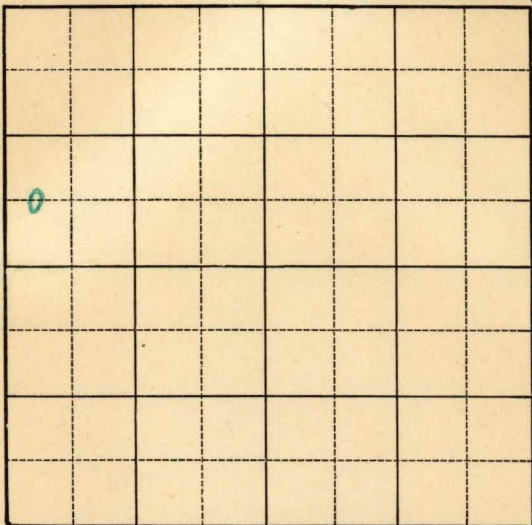

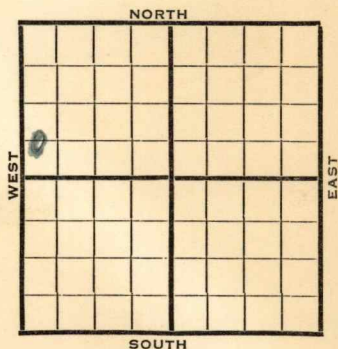[illegible]

Map No. _____ Sec. 5 Twp. 16 R. 10WWell No. 1 AdamekSkelly Oil

Company _____

Contractor _____

FIRST REPORT**C W L SW NW**

_____ Ft. from N. Line

660 Ft. from S. Line

_____ Ft. from E. Line

330 Ft. from W. Line**SECTION PLAT**

o			

STOLTENBERG POOL

Location _____

Rig up _____

Drilling and Remarks:

Cellar**RECORD**

Cased _____ in., _____ ft.

Sand _____

Gas _____

Oil _____

Total Depth _____

PRODUCTION

1st 24 hrs. Nat. _____

1st 24 hrs. after shot _____

Gas _____ Cu. Ft.

Dry Hole _____

Abandoned _____

Date

JUL 24 1940

19

S. J. LEWIS Scout

Map No. _____ Sec. 5 Twp. 16 R. 10WWell No. 1 AdamekSkelly Oil

Company _____

Contractor _____

ABANDONED

C W L SW NW

_____ Ft. from N. Line

660 Ft. from S. Line

_____ Ft. from E. Line

330 Ft. from W. Line

STOLTENBERG POOL

SECTION PLAT

0			

Location _____

Rig up _____

Drilling and Remarks:

*Cr 8329**No show*

RECORD

Cased _____ in., _____ ft.

Sand _____

Gas _____

Oil _____

Total Depth 3336

PRODUCTION

1st 24 hrs. Nat. _____

1st 24 hrs. after shot _____

Gas _____ Cu. Ft.

Dry Hole _____

Abandoned _____

Date

AUG 21 1940

19

S. J. LEWIS Scout