

Ellsworth


DX 78-1

KANSAS

Section 5 Township 16 Range 10W

Well No. #1 Adamek "A"

Company Grant Oil Co.

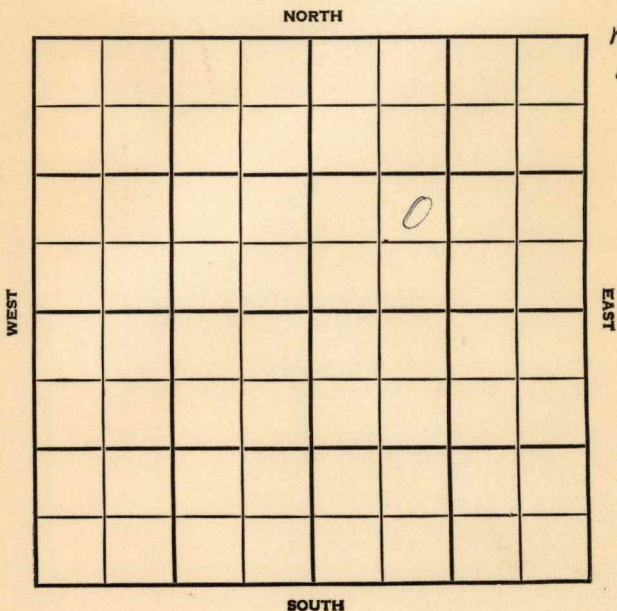

County Ellsworth Elev. 1796 DF
 Sec. 5 Twp. 16 Rge. LOW
 Company Grant Oil Co.
 Farm Name Adamek "A" No. 1

TOPS	DEPTH	LOG	DATUM
Anh.			
TP.	2539		
H.	2835		
Tr.	2854		
Dg.			
BL.	2935		
L.			
K.C.	2950		
B.K.C.			
Ce.			
C.			
M.			
M.			
K.			
Mz.			
Me.			
V.			
S.	3268		
S.			
A.	3289		
R.			
PE.			
G.			
TD.	3297		

Loc. in Sec. NE SW NE
 Geol. _____
 Contr. _____
Birmingham & Bartlett Tools
Pool
Stoltenberg

DEC 20 '56
 COMPLETE

Date Comm. spd. 10-20-56

8" @ 281 w/175, Drlg. below surface OCT 31 '56
 DST 3259-92 2 hrs see 33'
 OCM + 30' Md BHP 1070/30
 DST 3291-97 4 1/2 hrs 300' oil
 BHP 990/30" 5 1/2 @ 3291 NOV 7 '56
 CO 3297 FU 400' Fluid 2 hrs
 B 7 Boph + 1 Boph 2 hrs 400'
 O.B POP NOV 13 '56 NOV 21 '56 NOV 28 '56
 DEC 5 '56 P. 15.7 BO + 10 BW 24 hrs

DEC 12 '56 P. 10 1/2 Bo 24 hrs
no/wtr DEC 19 '56 comp. P.
10 1/2 Bopd no wtr.

5-16-100

ne sw ne