


Section 5 Township 16 Range 10W

Well No. ~~#1~~ ~~#2~~, Admek "A"

Company Sohio et al

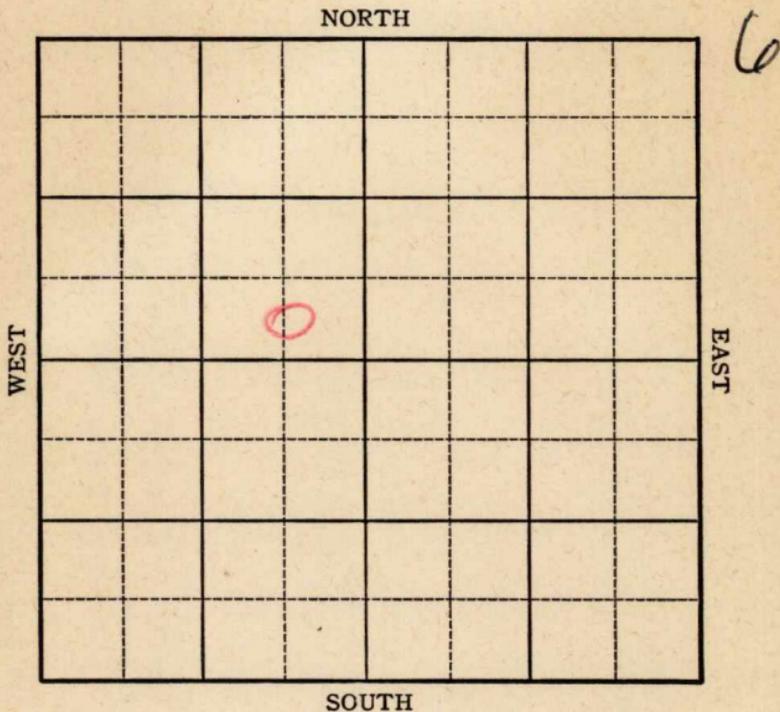

Sec. 5 Twp. 16 R. 10W

Well No. #2 Admek #1 "A" Farm _____

Sohio et al

Company

Stotlenberg

_____ Ft. from N. Line

330


_____ Ft. from S. Line

660

_____ Ft. from E. Line

_____ Ft. from W. Line

CSL SE NW

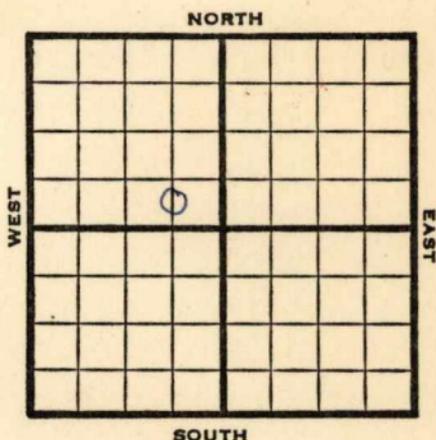

1946 **E1 v. 1766** REPORT

- 5/22 8" @ 309
Drlg. 1985'
- 5/29 **Arb. 3244-3245**
TD 3245
5" @ 3244 RUST
- 6/5 TD 3249
500 acid.
2600' oil 4 hrs.
- 6/12 " " "
- 6/18 " " "
- 6/26 " " "
- 7/3 " " "
- 7/9 " " "
- 7/16 " " "
- 7/23 " " "
- 7/30 TD3249'
- 8/7 **Arb. 3244**
5" @ 3244
500 acid.
TD 3249'
Pump 301 Pot.
Grav. 42.0

COMPLETED

KANSAS

Kansas Pool Name Stotlenberg

Map No. 53 Sec. 5 Twp. 16 R. 10W

Well No. 2 Admek

Sohio etal Company

FIRST REPORT

Contractor

C S L SE NW

SECTION PLAT

_____ Ft. from N. Line

330 Ft. from S. Line

660 Ft. from E. Line

_____ Ft. from W. Line

	0		

Ellsworth County

Location _____

Rig up _____

Drilling and Remarks:

*8" @ 809
July 1985*

RECORD

Cased _____ in., _____ ft.

Sand _____

Gas _____

Oil _____

Total Depth _____

PRODUCTION

1st 24 hrs. Nat. _____

1st 24 hrs. after shot _____

Gas _____ Cu. Ft.

Dry Hole _____

Abandoned _____

Date

MAY 22 1946

19

S. J. LEWIS

Scout

Kansas Pool Name Stoltenberg

KANSAS
 Map No. 35 Sec. 5 Twp. 16 R. 10W

Well No. 1 Admek "A"

Sohio etal. Company

CORRECTION Contractor

C S L SE NW

SECTION PLAT

 Ft. from N. Line

330 Ft. from S. Line

660 Ft. from E. Line

 Ft. from W. Line

Ellsworth County

Location

Rig up

Drilling and Remarks:

Reported as
 #2 Admek

RECORD

Cased in., ft.

Sand

Gas

Oil

Total Depth

PRODUCTION

1st 24 hrs. Nat.

1st 24 hrs. after shot

Gas Cu. Ft.

Dry Hole

Abandoned

Date

JUN 5 1946 19

S. J. LEWIS

Scout

Pool Name Stoltenberg Pool

KANSAS

Kansas

Map No. 55 Sec. 5 Twp. 16 R. 10W

Well No. 1 Admek "A"

Sohio etal. Company

COMPLETED

Contractor

C S L SE NW

E 11766
SECTION PLAT

 Ft. from N. Line

330 Ft. from S. Line

660 Ft. from E. Line

 Ft. from W. Line

	6		

Ellsworth County

Location

Rig up

Drilling and Remarks:

Cr 8244
5" @ 3244
500 cu ft
Pump 301 B

42° G

RECORD

Cased in., ft.

Sand

Gas

Oil

Total Depth 3242

PRODUCTION

1st 24 hrs. Nat.

1st 24 hrs. after shot

Gas Cu. Ft.

Dry Hole

Abandoned

Date

AUG 7 1946

19

S. J. LEWIS Scout