

KANSAS

Form 51—5M—7-39—Palace


Ellsworth

Section 5 Township 16 Range 10-W

Well No. #1 Haska

Company Magnolia

NORTH **Stoltenberg**

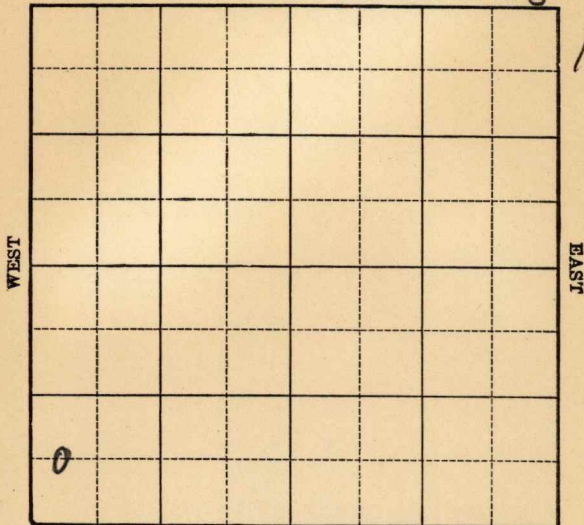

SOUTH

KANSAS

Ellsworth

FORM 252-A 5M 2-40

Sec. 5 Twp. 16 R. 10-WWell No. #1 Haska FarmMagnolia Company

(Stoltenberg)


Ft. from N. Line

660 Ft. from S. Line

Ft. from E. Line

330 Ft. from W. Line

Elev. 1816

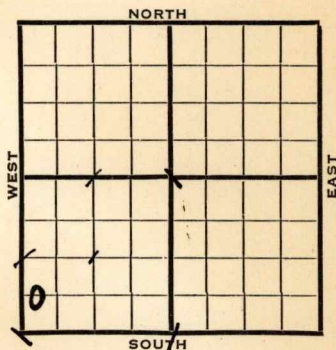

1940

REPORT

6/19

Drlg. 160'

6/27

10" - 310' Drlg. 1670'

7/3

Drlg. 2865'

7/11

Lans. 2975' Arb. ~~3292'~~ 3284'5" - ~~3295'~~ ³²⁸⁵ T.D. ~~3298'~~ ³²⁹⁶ Sat.

RUST.

7/18

Arb. 3284' (Corrected)

5" - 3285' T.D. 3296'

1000 acid. Testing.

7/24

Arb. 3284'

5" - 3285'

T.D. 3296'

1000 acid.

Echometer potential 1532 bbls.

COMPLETED

Map No. 55 Sec. 5 Twp. 16 R. 10W

Well No. 1 Haska
Magnolia


Company

Contractor

FIRST REPORT

C W L SW SW

SECTION PLAT

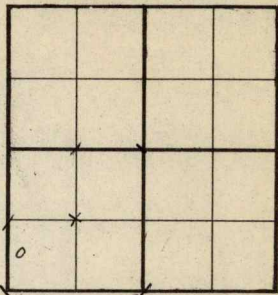

 Ft. from N. Line

660 Ft. from S. Line

 Ft. from E. Line

330 Ft. from W. Line

STOLTENBERG

Location

Rig up

Drilling and Remarks:

Drlg. 160

RECORD

Cased in., ft.

Sand

Gas

Oil

Total Depth

PRODUCTION

1st 24 hrs. Nat.

1st 24 hrs. after shot

Gas Cu. Ft.

Dry Hole

Abandoned

Date

JUN 19 1940

19

S. J. LEWIS Scout

Map No. _____ Sec. 5 Twp. 16 R. 10WWell No. 1 HaskaMagnolia

Company _____

Contractor _____

COMPLETED**SECTION PLAT****C W L SW SW**

_____ Ft. from N. Line

660 Ft. from S. Line

_____ Ft. from E. Line

330 Ft. from W. Line**STOLTENBERG POOL**

0			

Location _____

Rig up _____

Drilling and Remarks:

*Cor & 3284**5" @ 3285**1000 acid**Echometer & 8**1532***RECORD**

Cased _____ in., _____ ft.

Sand _____

Gas _____

Oil _____

Total Depth 3286**PRODUCTION**

1st 24 hrs. Nat. _____

1st 24 hrs. after shot _____

Gas _____ Cu. Ft.

Dry Hole _____

Abandoned _____

Date

JUL 24 1940 19**S. J. LEWIS** Scout