


Section 4 Township 16 S Range 10 W

Well No. #5 Borecky

Company Henderson

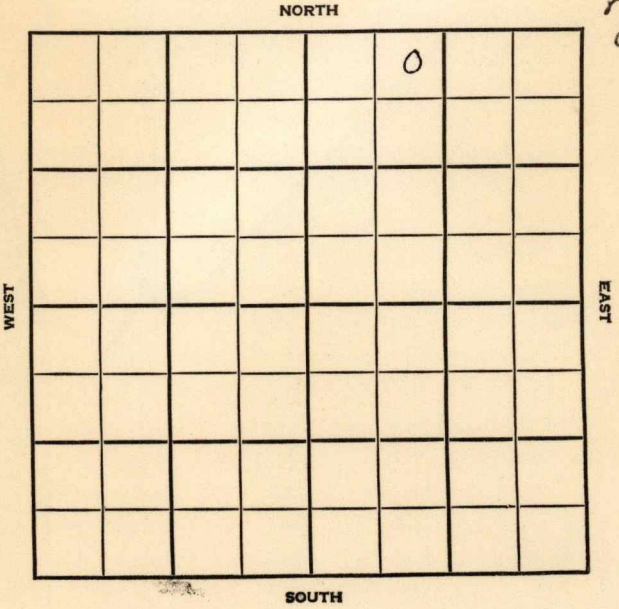

ELLSWORTH

KANSAS


SEC.	TWP.	R.
4	16S	10W

WELL NO. #5 Borecky FARM

COMPANY HENDERSON

CONTRACTOR Lewis Progress

\_\_\_\_\_ Ft. from N. Line  
 \_\_\_\_\_ Ft. from S. Line  
 \_\_\_\_\_ Ft. from E. Line  
 \_\_\_\_\_ Ft. from W. Line

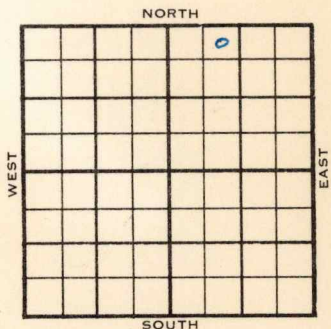

NE NW NE

1955	ELEVATION 1768 DF	REPORT
------	----------------------	--------

9/21 Comm 9-17-55  
 8" @ 328 w/200  
 D 1700

11/2 Comm 9-17-55  
 8" @ 328/200

- H 2796
- B1 2897
- L 2918
- C 3238
- A 3307
- TD 3315'

DST 3307-15 open 1 hr. rec 830' oil  
 965/15" 5 1/2" @ 3308/175 CO to 3315  
 FU 1000' oil 1 1/2 hr. S/13 boph P/11  
 boph 6 hr  
 Comp 282 bopd

**COMPLETED**

County ~~Elsworth~~ Elev. 1768 DF  
 Sec. 4 Twp. 16S Rge. 10W  
 Company Henderson  
 Farm Name Borecky No. 5

TOPS	DEPTH	LOG	DATUM	Loc. in Sec.
Anh.				NE NW NE
Tr.				
Dg.				
Bl.				
L.				Geol.
K.C.				Contr.
B.K.C.				Lewis
Ce.				Pool
C.				Progress
M.				
M.				
K.				
Mz.				
Mq.				
V.				
S.				
S.				
A.				
R.				
PE.				
G.				
T.D.				

FIRST REPORT

SEP 21 1955

Date Comm. 9-17-55  
 8" 328 w/200; D 1700

~~Francis Madsen  
 Pierce Madsen  
 MISC.~~

Co.  
 Lse.  
 No.  
 Sec.  
 T.  
 R.

County Ellsworth Elev. 1768  
 Sec. 4 Twp. 16 Rge. 10W  
 Company Henderson  
 Farm Name Borecky No. 5

TOPS	DEPTH	LOG	DATUM	Loc. in Sec.																					
Anh.				NE NW NE																					
Tr.																									
H.	2796		1028																						
Dg.																									
Bl.	2897		1129																						
L.	2918		1450	Geol.																					
K.C.				Contr.																					
C.	3238		1470	Lewis																					
M.				Pool																					
K.				Progress																					
Mz.				<table border="1"> <tr> <td></td> <td></td> <td>0'</td> </tr> <tr> <td></td> <td></td> <td></td> </tr> <tr> <td colspan="3" style="text-align: center;">COMPLETE</td> </tr> <tr> <td></td> <td></td> <td></td> </tr> <tr> <td></td> <td></td> <td></td> </tr> <tr> <td></td> <td></td> <td></td> </tr> <tr> <td></td> <td></td> <td></td> </tr> </table>			0'				COMPLETE														
		0'																							
COMPLETE																									
V.																									
S.																									
A	3307		1539																						
R.																									
P.																									
G.																									
T.D.	3315																								

Date Comm. 9-17-55 NOV 2 1955

8" @ 328/200 DST 3307-15 open 1 hr.  
 rec. 830' oil 965/15" 5 1/2" @ 3308/175  
 CO to 3315 FU 1000' oil 1 1/2 hr.  
 S/ 13 boph P/ 11 boph 6 hr.  
 Comp. 282 bopd

Co.

Lse.

No.

Sec.

T.

R.