


Section 9 Township 14 Range 14W

Well No. #1 Williams Rusch

Company Murfin Drlg.

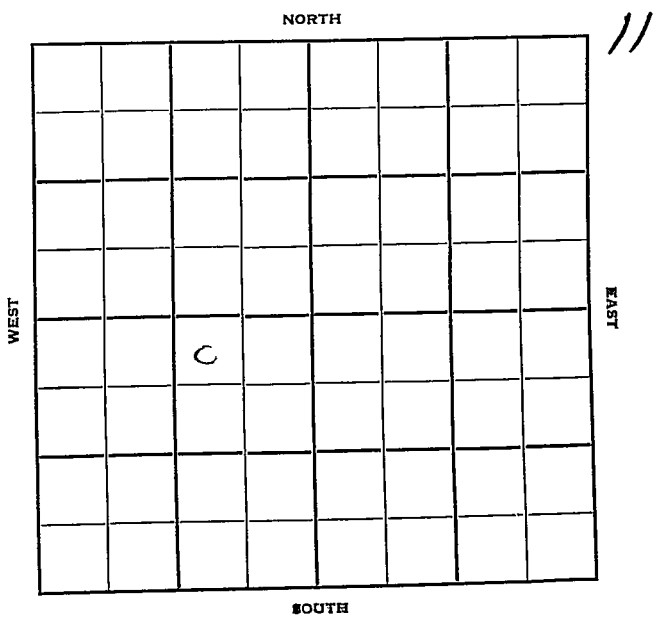

Russell



Sec. 9 Twp. 14 **KANSAS** R. 14W

Well No. #1 Williams Farm

Murfin Drlg. Company

Contractor


330 Ft. from N. Line

Ft. from S. Line

990 Ft. from E. Line

Ft. from W. Line

SW $\frac{1}{4}$ NW NE SW

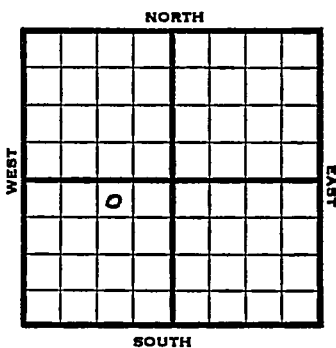

1952	Elev. 1868'	REPORT
11/5		RUCT
11/12		15" @ 383'
		12" @ 584'
		Drlg. 650'
11/20		Drlg. 1680'
11/27		Fishing
12/4		"
12/11		Tarkio 2475 So 2490' 2500 1/2 BOPH TD 2517 PB 2500 7" @ 2491
12/18		CO @2500
12/23		Spud 11-6-52 Oil well TD 2517' 15" @ 383 12" @ 584 Anhy 880' 10" @ 880 Tarkio 2475' SO 2490-2500 1/2 BOPH TD 2517' PB 2500 7" @ 2491. CO to 2500 St-frac. S/3 BOPH Comp. 25 BOPH COMPLETED

Map No. _____ Sec. 9 Twp. 14 R. 14W

Well No. 1 Rusch

Murfin Drlg. Company

CORRECTION Contractor

NW NE SW'

330 Ft. from N. Line

_____ Ft. from S. Line

990 Ft. from E. Line

_____ Ft. from W. Line

SECTION PLAT

	o		

Russell County

Location _____

Rig up _____

Drilling and Remarks:

Reported
#1 Williams

RECORD

Cased _____ in., _____ ft.

Sand _____

Gas _____

Oil _____

Total Depth _____

PRODUCTION

1st 24 hrs. Nat. _____

1st 24 hrs. after shot _____

Gas _____ Cu. Ft.

Dry Hole _____

Abandoned _____

Date

NOV 12 1957

19

J. G. McQUEE

Scout

