


Section 10 Township 14 Range 11W

Well No. #8 Boxberger

Company The Texas Co.

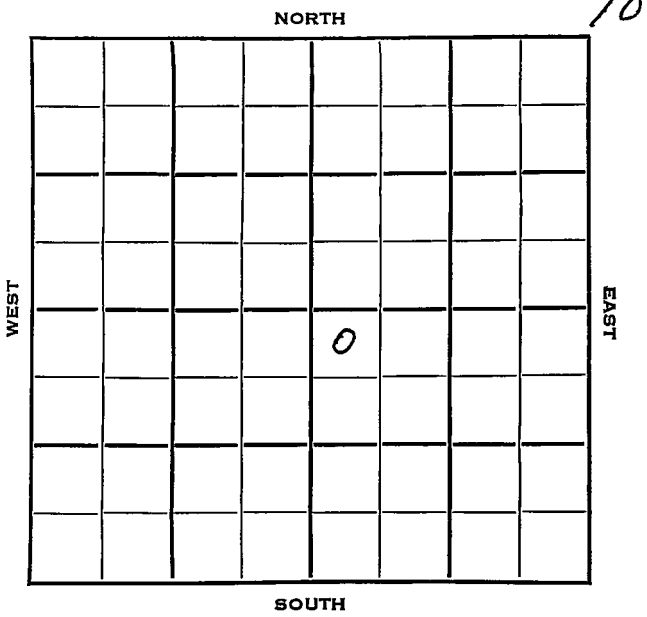

Sec. 10 Twp. 14 R. 14W

Well No. #8<sup>B</sup> oxberger Farm

The Texas Co. Company

Powell Contractor

Hall Gurney Pool


330 Ft. from N. Line

Ft. from S. Line

Ft. from E. Line

330 Ft. from W. Line

NW NW SE

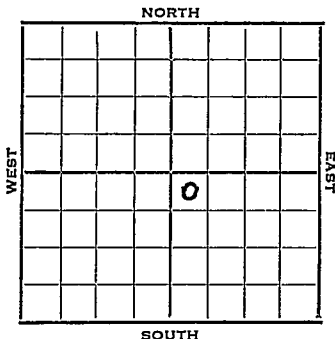

1953 Elev. 1848' REPORT

- 7/14 Spud 7-10-53  
10" @ 841, WOC
- 7/22 Drlg. 3005'
- 7/29 Tarkio 2490, Heeb 2936, Lans 2996,  
Reagan 3253  
TD 3258  
7" @ 3254, CO
- 8/5 Spud 7-10-53  
Oil Well  
TD 3258  
10" @ 841  
Tarkio 2490, Heeb 2936, Lans 2996,  
Regan 3253,  
TD 3258  
7" @ 3254  
CO to 3258  
FU 1000' oil, 1 hr.,  
S/53 boph 3 hrs.  
S/23 bo 1 bwph 6 hrs.  
Comp. 391 bopd

**COMPLETED**

County Russell State Kansas

Sec. 10 (Blk. Twp.) 14 (Sur. Rge.) 14W Map No.

Operator The Texas Co.

Well No. 8 Farm Boxberger

Elev. \_\_\_\_\_ Location NW NW SE


FIRST REPORT

330 Ft. From N Line SE

330 Ft. From W Line Quarter

1st. Report JUL 14 1953

Completion \_\_\_\_\_

Remarks \_\_\_\_\_

Powell-Contr.

Spudding Date 7-10-53

Drlg. Data Hall Gurney pool

10" @ 841 WOC

J. G. MCGEE

