

KANSAS

Ellsworth


Form 51—5M—7-39—Palace

Section 5 Township 16 Range 10-W

Well No. #1 Haska
Jayhawk Drig.

Company Vickers

NORTH Stoltzenberg Pool

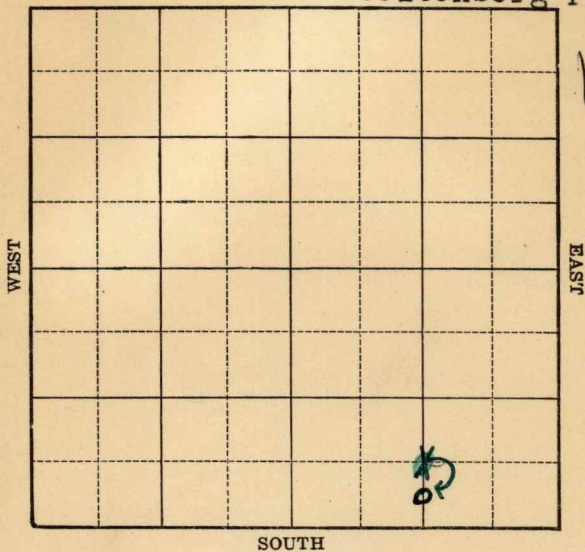


Sec. 5 Twp. 16 R. 10-WWell No. #1 Haska FarmVickers Jayhawk Drlg Company

(Stoltenberg)

 Ft. from N. Line330
660 Ft. from S. Line1320 Ft. from E. Line Ft. from W. Line

Elev. 1816

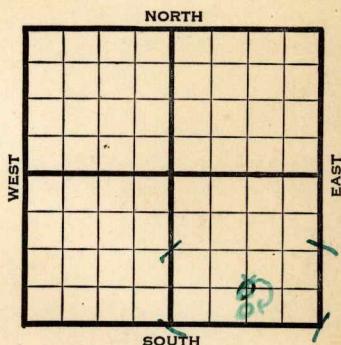

1940

REPORT

10/2

Location

10/10

Derrick.

10/17

10" - 306' Drlg. 1500'

10/24

" " " "

10/31

Lans. 2965' - Arb. 3272'

5" - 3273' T.D. 3282'

Swab 35 bbls. per hr. 2 hours.

11/7

2000 acid. Depth. pot. 2266

Drlg. 3286'

11/13

Arb. 3272'

5" - 3273'

T.D. 3289'

2000 acid.

Depthograph potential 2266 bbls.

COMPLETED

Map No. 55 Sec. 5 Twp. 16 R. 10W

Well No. 1 Haska

Vickers Company

Contractor

FIRST REPORT

C S $\frac{1}{2}$ SE

 Ft. from N. Line


660 Ft. from S. Line

1320 Ft. from E. Line

 Ft. from W. Line

STOLTENBERG POOL

SECTION PLAT

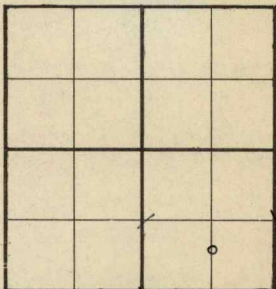

Location X

Rig up

Drilling and Remarks:

RECORD

Cased in., ft.

Sand

Gas

Oil

Total Depth

PRODUCTION

1st 24 hrs. Nat.

1st 24 hrs. after shot

Gas Cu. Ft.

Dry Hole

Abandoned

Date

OCT 2 1940 19

S. J. LEWIS Scout

Map No. 55 Sec. 5 Twp. 16 R. 10W

Well No. 1 Haska

Vickers

Company

CORRECTION

Contractor

SECTION PLAT

C S L SE

Ft. from N. Line

330 Ft. from S. Line

1320 Ft. from E. Line

Ft. from W. Line

STODTENBERG POOL

Location

Rig up

Drilling and Remarks:

Reported

C S $\frac{1}{2}$ SE

RECORD

Cased in., ft.

Sand

Gas

Oil

Total Depth

PRODUCTION

1st 24 hrs. Nat.

1st 24 hrs. after shot

Gas Cu. Ft.

Dry Hole

Abandoned

Date

OCT 10 1940 19

S. J. LEWIS

Scout


Map No. 55 Sec. 5 Twp. 16 R. 10WWell No. 1 HaskaJayhawk Drlg. CompanyCORRECTION Contractor

C S L SE

 Ft. from N. Line330 Ft. from S. Line1320 Ft. from E. Line Ft. from W. Line

STOLTENBERG POOL

SECTION PLAT

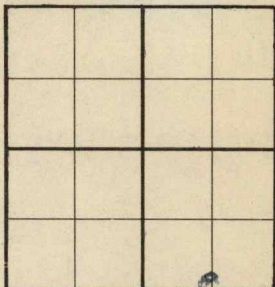Location Rig up

Drilling and Remarks:

Reported as

Vickers

RECORD

Cased in., ft.Sand Gas Oil Total Depth

PRODUCTION

1st 24 hrs. Nat. 1st 24 hrs. after shot Gas Cu. Ft.Dry Hole Abandoned

Date

OCT 31 1940

19

S. J. LEWIS Scout

Map No. 55 Sec. 5 Twp. 16 R. 10WWell No. 1 Haska

Jayhawk Drilling

Company

Contractor

COMPLETED

C S L SE

_____ Ft. from N. Line

330 Ft. from S. Line1320 Ft. from E. Line

_____ Ft. from W. Line

SECTION PLAT

STOLTENBERG POOL

Location _____

Rig up _____

Drilling and Remarks:

*Art. 3272**5" C 3273**2000 sand**Depth. RT 2266*

RECORD

Cased _____ in., _____ ft.

Sand _____

Gas _____

Oil _____

Total Depth 3289

PRODUCTION

1st 24 hrs. Nat. _____

1st 24 hrs. after shot _____

Gas _____ Cu. Ft.

Dry Hole _____

Abandoned _____

Date

NOV 13 1940 19 S. J. LEWIS Scout