


Section 5 Township 16 Range 10W

Well No. 1 Haska

Company Nadel & Gussman

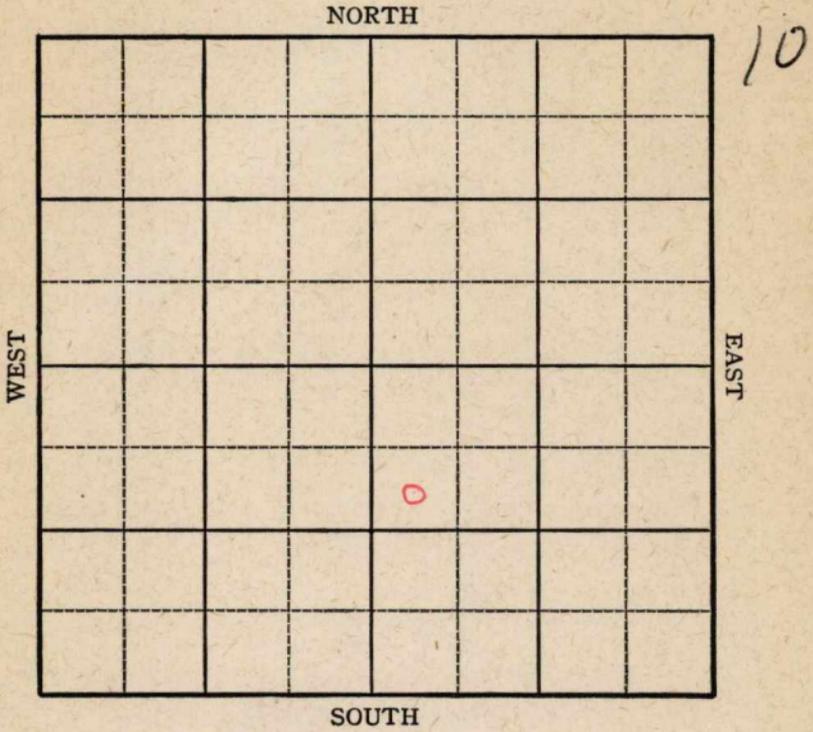

KANSAS

Ellsworth

Sec. 5 Twp. 16 R. 10-W


Well No. #1 Haska Farm _____
Nadel & Gussman Company _____

990 Ft. from N. Line

_____ Ft. from S. Line

_____ Ft. from E. Line

330 Ft. from W. Line

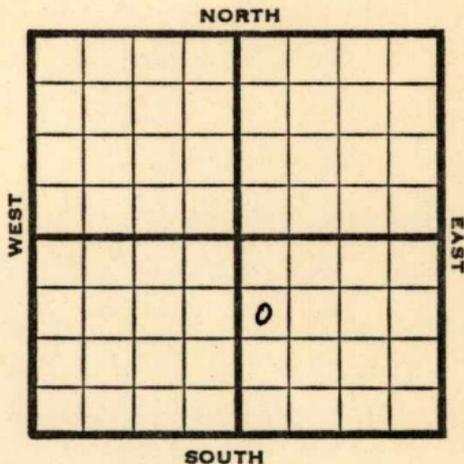

SW NW SE

1945 **Elev. 1856** REPORT

10/3 8" @ 300'
Drlg. 1589'

10/10 Drlg. 2555

10/17 **Lans 3013**
Arb. 3322-3324

TD 3324

5" @ 3322 RUST

10/24 TD 3327

3000' oil 12 hrs.

" " "

" " "

11/14 **Arb. 3322**

5" @ 3322

TD 3327'

Echo Pot. 1139

Grav. 42.0

COMPLETED

KANSAS

Kansas

Pool Name Stoltenberg

Map No. 55 Sec. 5 Twp. 16 R. 10W

Well No. 1 Haska

Nadel & Gussman Company

FIRST REPORT Contractor

SW NW SE


SECTION PLAT

990 Ft. from N. Line

_____ Ft. from S. Line

_____ Ft. from E. Line

330 Ft. from W. Line

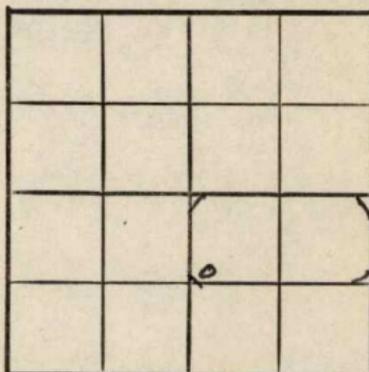

Ellsworth

Location _____

Rig up _____

Drilling and Remarks:

8" - 300'
1589

RECORD

Cased _____ in., _____ ft.

Sand _____

Gas _____

Oil _____

Total Depth _____

PRODUCTION

1st 24 hrs. Nat. _____

1st 24 hrs. after shot _____

Gas _____ Cu. Ft.

Dry Hole _____

Abandoned _____

Date

OCT 3 1945 19

S. J. LEWIS Scout

KANSAS

Kansas Pool Name Stoltenberg

Map No. 55 Sec. 5 Twp. 16 R. 10W

Well No. 1 Haska

Nadel & Gusman Company

COMPLETED

Contractor

E 11856

SW NW SE

SECTION PLAT

990 Ft. from N. Line

_____ Ft. from S. Line

_____ Ft. from E. Line

330 Ft. from W. Line

Ellsworth County

Location _____

Rig up _____

Drilling and Remarks:

Per 83322

5" 83322

Echo 1189

42°/hr

RECORD

Cased _____ in., _____ ft.

Sand _____

Gas _____

Oil _____

Total Depth 8327

PRODUCTION

1st 24 hrs. Nat. _____

1st 24 hrs. after shot _____

Gas _____ Cu. Ft.

Dry Hole _____

Abandoned _____

Date

NOV 14 1945 19

S. J. LEWIS

Scout