

KANSAS

Form 51—5M—7-40—Palace

Ellsworth

Section 5 Township 16 Range 10-W

Well No. #1 Jim Horejsi


Company Aylward Production

Stoltenberg Pool

NORTH

WEST

EAST

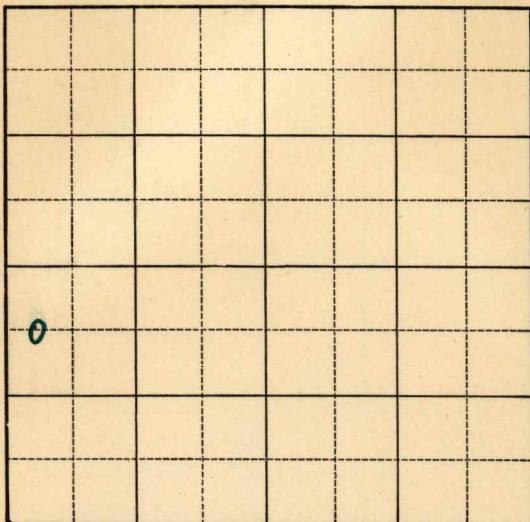

SOUTH

KANSAS

Ellsworth

FORM 252-A 5M 2-40


Sec. 5 Twp. 16 R. 10-WWell No. #1 Jim Horejsi FarmAylward Production Company

(Stoltenberg)

660 Ft. from N. Line

Ft. from S. Line

Ft. from E. Line

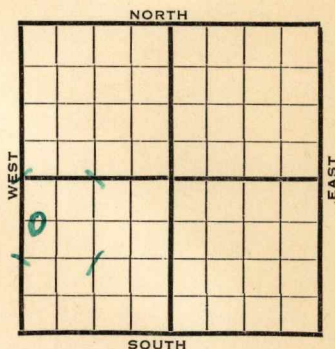330 Ft. from W. Line

Elev. 1824

1940	REPORT
7/31	Rotary Derrick.
8/8	" " "
8/14	Rigging up
8/22	10" - 260' Anhy 625'
	Drlg. 2255'
8/29	Cong. 3290' Arb. 3310-11½' T.D.
	Run 5".
9/5	5" - 3310' T.D. 3319'
	800 acid. Swab 80 bbls. in 9
	hours. Fsg. swab.
9/11	Arb. 3310'
	5" - 3310'
	T.D. 3319'
	Pump 240 bbls. water 4 hours.

ABANDONED

Map No. 55 Sec. 5 Twp. 16 R. 10WWell No. 1 Jim HorejsiAylward Production


Company

Contractor

FIRST REPORT

C $W\frac{1}{2}$ NW SW660 Ft. from N. Line Ft. from S. Line Ft. from E. Line330 Ft. from W. Line

SECTION PLAT

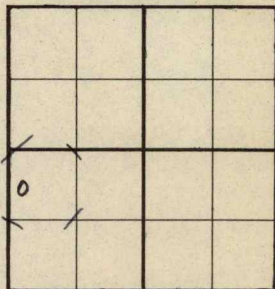

STOLTENBERG POOL

Location Rig up

Drilling and Remarks:

Rotary Derrick

RECORD

Cased in., ft.Sand Gas Oil Total Depth

PRODUCTION

1st 24 hrs. Nat. 1st 24 hrs. after shot Gas Cu. Ft.Dry Hole Abandoned

Date

JUL 31 1940 19S. J. LEWIS Scout

Map No. 55 Sec. 5 Twp. 16 R. 10WWell No. 1 Jim HorejsiAylward Production Company

Contractor

ABANDONED

C $W\frac{1}{2}$ NW SW660 Ft. from N. Line

_____ Ft. from S. Line

_____ Ft. from E. Line

330 Ft. from W. Line

STOLTENBERG POOL

SECTION PLAT

0			

Location _____

Rig up _____

Drilling and Remarks:

*Re 3310**5" C 3310**Pump 240 lbs Water
4 hrs.*

RECORD

Cased _____ in., _____ ft.

Sand _____

Gas _____

Oil _____

Total Depth 3319

PRODUCTION

1st 24 hrs. Nat. _____

1st 24 hrs. after shot _____

Gas _____ Cu. Ft.

Dry Hole _____

Abandoned _____

Date

SEP 11 1940 19S. J. LEWIS Scout