

KANSAS


FORM 51 5M 1-42 PETROL

Russell

Section 10 Township 14 Range 14-W

Well No. #1 Newcomer

Company Gulf

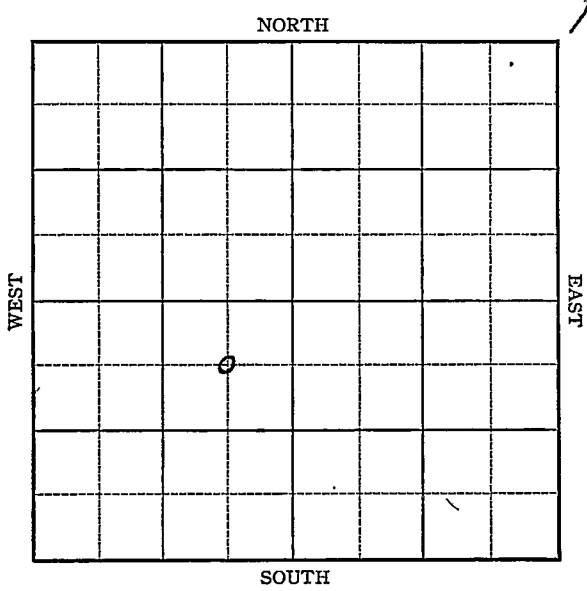

KANSAS

Russell

Sec. 10 Twp. 14 R. 14-W

Well No. #1 Newcomer Farm

Gulf

Company


Witt

660 Ft. from N. Line

_____ Ft. from S. Line

660 Ft. from E. Line

_____ Ft. from W. Line

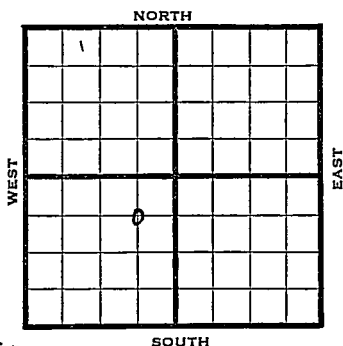

2lev. 1853

1943

REPORT

8/4 Location.

8/11 8" @ 564'
Drlg. 1140'

8/18 Lans 2999
Drlg. 3089 SO

~~8/25~~ 5" @ 3305'
Plug 3267'

9/1 Lans 2999
Gorham 3262
5" @ 3268 $\frac{1}{2}$
Perf. Lans
4000 acid
Pump 3939 oil & 177 water
T.D. 3269 $\frac{1}{2}$
Grav. 35

COMPLETED

Map No. ~~KANSAS~~ Sec. 10 Twp. 14 R. 14WWell No. 1 NewcomerGulf CompanyFIRST REPORT Contractor

C NE SW

SECTION PLAT

660 Ft. from N. Line Ft. from S. Line660 Ft. from E. Line Ft. from W. Line

	o		.

WITT POOLLocation XXXRig up

Drilling and Remarks:

RECORD

Cased in., ft.Sand Gas Oil Total Depth

PRODUCTION

1st 24 hrs. Nat. 1st 24 hrs. after shot Gas Cu. Ft.Dry Hole Abandoned

Date

AUG 4 1943S. J. LEWIS Scout

KANSAS

Map No. 72 Sec. 10 Twp. 14 R. 14WWell No. 1 NewcomerGulf CompanyCOMPLETED Contractor

C NE SW

SECTION PLAT

660 Ft. from N. Line Ft. from S. Line660 Ft. from E. Line Ft. from W. Line

	o		

Witt Pool

Location Rig up

Drilling and Remarks:

Li ens 2999
Go kam 3262
5" @ 3268 1/2
Prof done.
4000 accid C
Pump 393 oil +
177 Water

RECORD

Cased in., ft.Sand Gas Oil Total Depth 3269 1/2

PRODUCTION

1st 24 hrs. Nat. 1st 24 hrs. after shot Gas Cu. Ft.Dry Hole Abandoned Date 35-9-44

SEP 1 1943 19

S. J. LEWIS Scout