

KANSAS

Form 51—5M—7-40—Palace


Ellsworth

Section 5 Township 16 Range 10-W

Well No. #2 Haska

Company Magnolia

NORTH Stoltenberg Pool

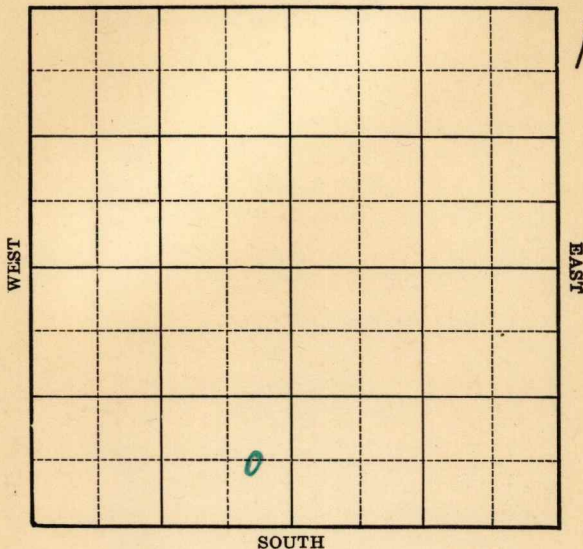

Map No. 55 Sec. 5 Twp. 16 R. 10WWell No. 2 HaskaMagnolia CompanyFIRST REPORT Contractor

C E L S E S W

SECTION PLAT

 Ft. from N. Line660 Ft. from S. Line330 Ft. from E. Line Ft. from W. Line

STOLTENBERG POOL

Location XRig up

Drilling and Remarks:

RECORD

Cased in., ft.Sand Gas Oil Total Depth

PRODUCTION

1st 24 hrs. Nat. 1st 24 hrs. after shot Gas Cu. Ft.Dry Hole Abandoned

Date

NOV 6 1940 19 S. J. LEWIS Scout

Map No. 55 Sec. 5 Twp. 16 R. 10WWell No. 2 HaskaMagnolia

Company

Contractor

COMPLETED
C E L S E S W**SECTION PLAT**

8

_____ Ft. from N. Line

660 Ft. from S. Line330 Ft. from E. Line

_____ Ft. from W. Line

STOLTENBERG POOL

Location _____

Rig up _____

Drilling and Remarks:

*Ar 8 2316**5" C 3319**1000 acid**Pump 110 oil 110 Water**Ar 44° Gr.***RECORD**

Cased _____ in., _____ ft.

Sand _____

Gas _____

Oil _____

Total Depth 3327**PRODUCTION**

1st 24 hrs. Nat. _____

1st 24 hrs. after shot _____

Gas _____ Cu. Ft.

Dry Hole _____

Abandoned _____

Date

DEC 30 1940

19

S. J. LEWIS

Scout