


Ellis

KANSAS

SECTION 23 TOWNSHIP 15S RANGE 17W

WELL NO. #2 John Roth

COMPANY Alpine O&R

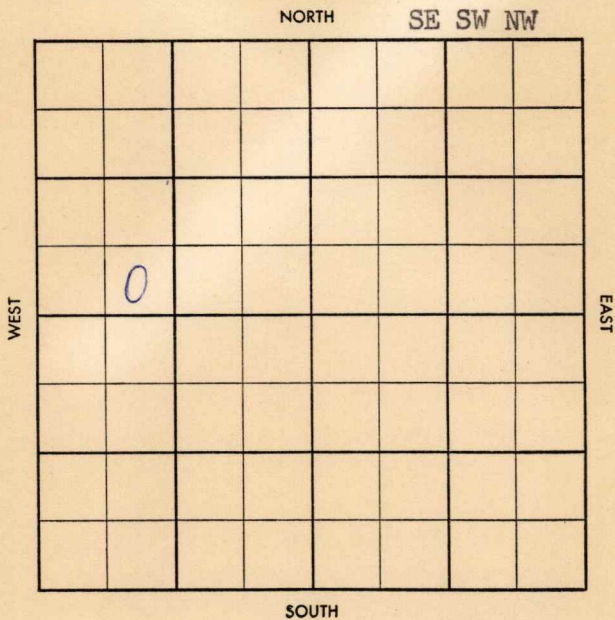

CO. ~~Ellis~~ ELEV. 1950
SEC. ~~23~~ TWP. 15 RGE. 17W
COMPANY Alpine O. & R. NO. 2

DEC 18 '57
0
COMPLETE

FARM John Roth
LOC. SE SW NW

Tops	
Anhy.	1087
H 3191	
TR 3212	
KC 3239	1289
BKC 3469	1519
C 3482	1532
A 3520	1570
TD 3523	

GEOL.
CONTR. Quaker Drlg. tools
POOL Degenhart SE
SPUD 9-28-57
8" @ 1094 w/600, Drlg.
1530 OCT 9 '57
5 1/2 3523/125 w/c
3247-92
60" 30' 50' 6 GCM
160' 0' 66.9 Mdy SW

FP 0-639 BHP 1194-1146
DST 3300-46 60" 25' M
BHP 770-365/20" DST
3357-95 60" 25' 50 SPK
M P 220 DST 3410-45
60" 135' HOC M
FP 0-50 BHP 482-412
DST 3450-70 60' 5' M
allp 0 OCT 30 '57 NOV 6 '57 DD 3530
#1 BOP NW 6 hrs Nat.

1/2 \$ 1.67 BOP NW 8 hrs
POP NOV 13 '57 NOV 20 '57 NOV 27 '57 DEC 4 '57

DEC 11 '57 DEC 18 '57

PHY P 176 BOP NW
37.8° N
new zone

CO.
LSE.
NO.
SEC.
TWP.
RGE.

