


Section 10 Township 14 Range 11W

Well No. ~~2#~~ Newcomer "B"

Company Chet Roberts

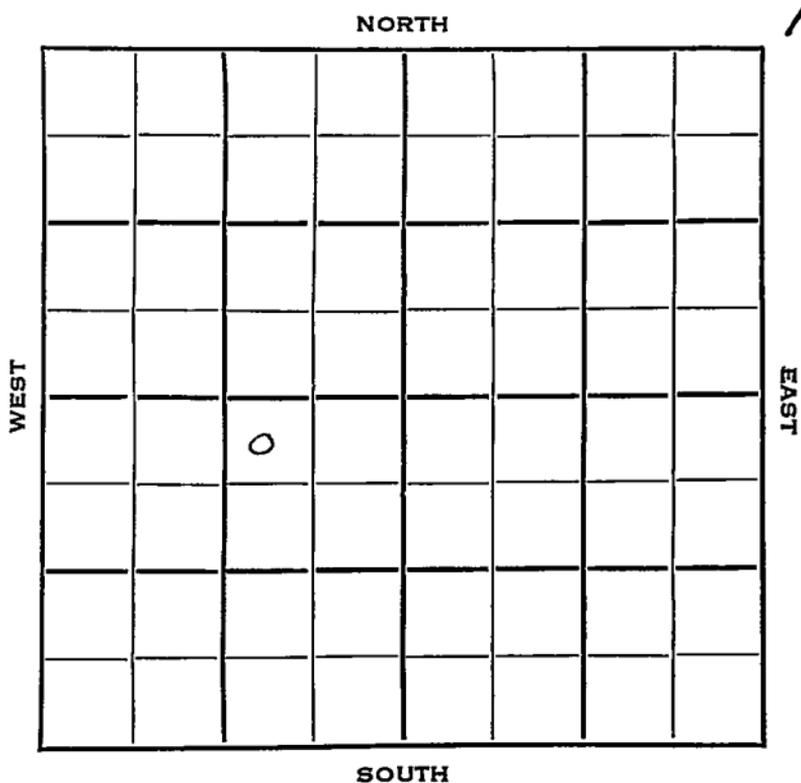

Russell KANSAS ✓

Sec. 10 Twp. 14 R. 11W

Well No. #2 Newcomer "C" "B" Farm

Chet Roberts Company

Chet Roberts - Contr. Contractor


330 Ft. from N. Line

Ft. from S. Line

990 Ft. from E. Line

Ft. from W. Line

NW NE SW

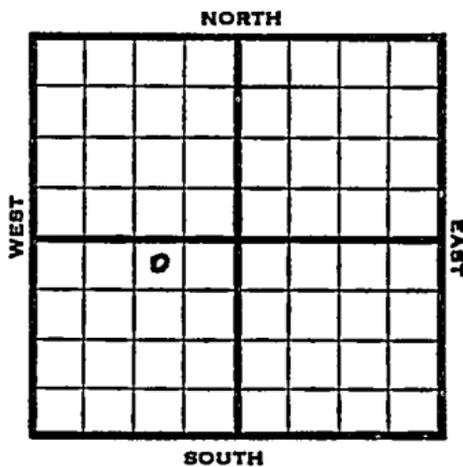

1953 Elev. 1849' REPORT

4/1 Spud 3-29-53
8" @ 733

4/9 Tarkio 2465, Top 2802, Heeb 2941, KC 3003
Drlg 3084'

4/16 RTD 3261
5" @ 3261'

4/23 NR

4/30 NR

5/6 Spud 3-29-53 Oil well TD 3261
8" @ 733 Tarkio 2465 Top 2802
Heeb 2941 KC 3003 Regan 3260
TD 3261 5" @ 3260 CO to 3261
FU 2400' oil 3 hr.
Comp. 25 BOPD

COMPLETED

County Russell State KANSAS

Sec. 10 (Blk. Twp.) 14 (Sur. Rge.) 14W Map No.

Operator Chet Roberts

Well No. 1 Farm Newcomer "B"

Elev. Location NW NE SW

| | | | | | |
|--|--|--|--|--|--|
| | | | | | |
| | | | | | |
| | | | | | |
| | | | | | |
| | | | | | |
| | | | | | |
| | | | | | |
| | | | | | |

FIRST REPORT

0

330 Ft. From N Line SW

990 Ft. From E Line Quarter

1st. Report APR 1 1953

Completion _____

Remarks _____

Chet Roberts - Contr.

Spudding Date 3-29-53

Drlg. Data _____

8" @ 733

Map No. _____ Sec. 10 Twp. 14 R. 14W

Well No. 2 Newcomer "C"

Chet Roberts Company

CORRECTION Contractor

NW NE SW

SECTION PLAT

330 Ft. from N. Line

_____ Ft. from S. Line

990 Ft. from E. Line

_____ Ft. from W. Line

| | | | |
|--|---|--|--|
| | | | |
| | | | |
| | D | | |
| | | | |

Russell County

Location _____

Rig up _____

Drilling and Remarks:

Reported
#1 Newcomer "B"

RECORD

Cased _____ in., _____ ft.

Sand _____

Gas _____

Oil _____

Total Depth _____

PRODUCTION

1st 24 hrs. Nat. _____

1st 24 hrs. after shot _____

Gas _____ Cu. Ft.

Dry Hole _____

Abandoned _____

Date

APR 8 1953 19

J. G. McGEHEE

Scout


County Russell State Kansas

Sec. 10 (Blk. 14) (Sur. 14W) (Rge.) Map No.

Operator Chet Roberts

Well No. 2 Farm Newcomer "C"

Elev. 1849 Location NW NE SW

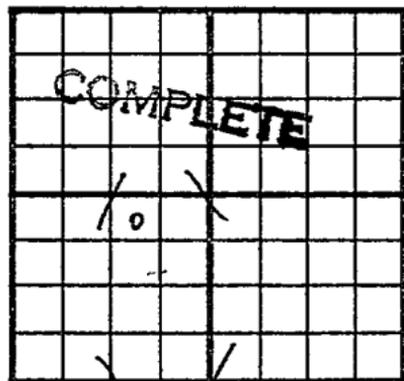

330 Ft. From N Line SW

990 Ft. From E Line Quarter

1st. Report

Completion MAY 6 1953

Remarks

Chet Roberts - Contr.

Spudding Date 3-29-53

Drlg. Data Oil well TD 3261

8" @ 733 Trakio 2465 Top. 2802

Heeb. 2941 KC 3003 . Regan 3260

TD 3261 5" @ 3260 CO to 3261

FU 2400' oil 3 hr. Comp. 25 bopd