

KANSAS

FORM 51 SM 1-42 PETROL

O.W.W.O. Russell

KANSAS

Section 10 Township 14 Range 14 W

Well No. #2 Newcomer

Company Stnolind

2

				0			

NORTH

SOUTH

WEST

EAST

KANSAS O.W.W.O.

Russell


Sec. 10 Twp. 14 R. 14-W

Well No. #2 New Comer Farm

Stanolind Company

Witt

NORTH

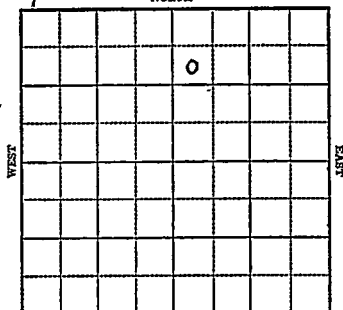

990 Ft. from N. Line

 Ft. from S. Line

 Ft. from E. Line

330 Ft. from W. Line

Elev. 1844

SOUTH

1943

R E P O R T

6/23

8" @ 525'

anhy 825'

Drlg. 1284'

6/30

Topeka 2710'

Drlg. 2913'

7/7

Lans 2988

Sovy sd 3253

T. D. 3260 Sat

7/15

5" @ 3253 Rust

Drill cement to 3283-36 shots

3030-38

3000 acid.

7/21

Lans 2988

5" @ 3253'

T.D. 3260'

Perf. Lans.

7500 acid

Pump 100 Pot.

Gravity 38.7

COMPLETED

O.W.W.O.

1953

10/14

Oil Well

TD 3260'

Lans 2988

5" @ 3253'

Regan 3254


OVER

KANSASMap No. 72 Sec. 10 Twp. 14 R. 14WWell No. 2 Newcomer**Stanolind**

Company

FIRST REPORT

Contractor

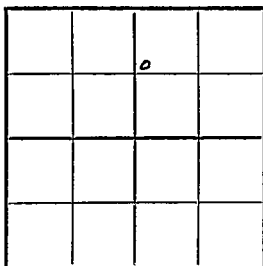SW NW NE**SECTION PLAT**990 Ft. from N. Line Ft. from S. Line Ft. from E. Line330 Ft. from W. Line**WIT' POOL**Location Rig up

Drilling and Remarks:

8"-525'**Anhy. 825'****Dr1g. 1284'****RECORD**Cased in., ft.Sand Gas Oil Total Depth **PRODUCTION**1st 24 hrs. Nat. 1st 24 hrs. after shot Gas Cu. Ft.Dry Hole Abandoned

Date

JUN 23 1943

19

S. J. LEWIS Scout

KANSAS
 Map No. 72 Sec. 10 Twp. 14 R. 14W
 Well No. 2 New comer

Stanolind Company

COMPLETED Contractor

SW NW NE

990 Ft. from N. Line

_____ Ft. from S. Line

_____ Ft. from E. Line

330 Ft. from W. Line

WITT POOL

SECTION PLAT

		o	

Location _____

Rig up _____

Drilling and Remarks:

lane 2988

5" C 3253

Pay. lane.

75000000

Pump 100 P.S.

38242

RECORD

Cased _____ in., _____ ft.

Sand _____

Gas _____

Oil _____

Total Depth 3260

PRODUCTION

1st 24 hrs. Nat. _____

1st 24 hrs. after shot _____

Gas _____ Cu. Ft.

Dry Hole _____

Abandoned _____

Date

JUL 21 1943 19

S. J. LEWIS Scout

G.W.W.O.

County Russell State Kansas
 Sec. 10 (Blk.) 14 (Sur.) 14W Map No. 14W
 Operator Stanolind
 Well No. 2 Farm C. L. Newcomer
 Elev. 1845 Location SW NW NE

FIRST REPORT
COMPLETE

990 Ft. From N Line NE
330 Ft. From W Line Quarter
 1st. Report OCT 14 1953
 Completion OCT 14 1953
 Remarks G.W.W.O.
 Spudding Date _____

Drig. Data Oil well TD 3260
Lans. 2988 5" @ 3253 Regan 3254
OTD 3260 PB 3233 sq. 2990-3002
3030-38 PB 2955 CO to 3260 11 boph
3 hr. 7 boph Comp. 1996 boph

J. G. McGEHEE

1953

Information brought forward.

10/14 OTD 3260
PB 3233
Sq. 2990-3002, 3030-38
PB 2955
CO to 3260
11 boph 3 hr. 7 boph
Comp 1996 bopd.

FIRST REPORT
✓
COMPLETED