

DX 78-1

Ellsworth

**KANSAS**

5


16

10 W

Section \_\_\_\_\_ Township \_\_\_\_\_ Range \_\_\_\_\_

Well No. #1 Vacek

Company Grant Oil

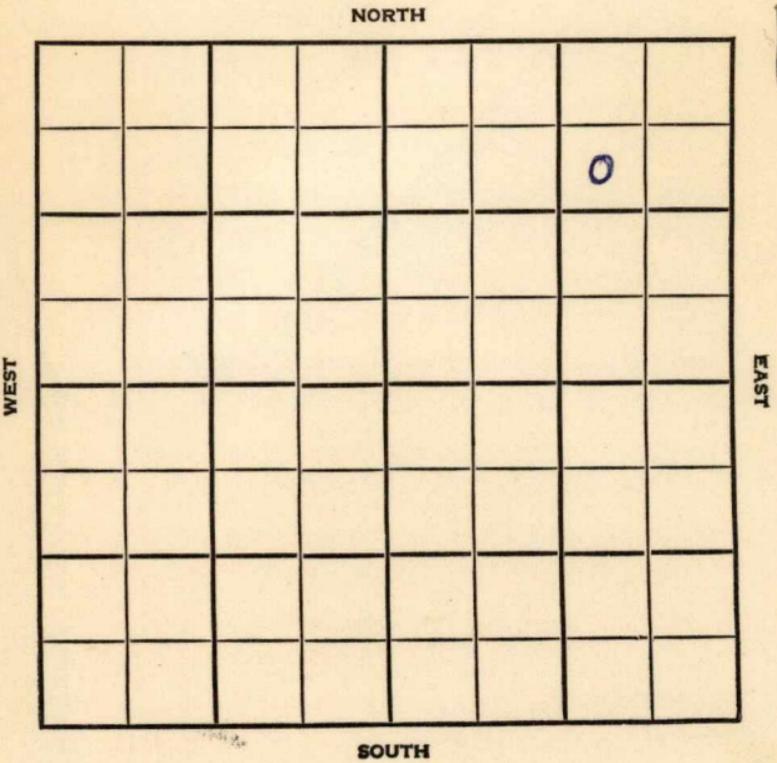




County Ellsworth Elev. 1836  
 Sec. 5 Twp. 16 Rge. LOW  
 Company Grant Oil  
 Farm Name Vacek "B" No. 1

TOPS	DEPTH	LOG	DATUM
Anh.			
Tp.			
H.		2880	
Tr.		2901	
Dg.			
Bl.		2981	1145
L.		2998	1162
K.C.			
B.K.C.			
Ce.			
C. <i>shly</i>		3320	1484
M.			
M.			
K.			
Mz.			
Mq.			
V.			
S. <i>sh</i>		3331	1495
S. <i>sd</i>		3332	1496
A.		3354	1518
R.			
Pe.			
G.			
Tp.	3359		

Loc. in Sec. SW NE NE  
 Geol. \_\_\_\_\_  
 Contr. Dutch George  
 Pool Stoltenberg

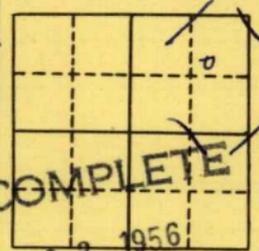

Date Comm. 2-5-56 MAY 23 1956  
 8" @ 307 DST 3261-65 open 1/2 hr.  
 rec. 1630' oil 1015# 5 1/2" @ 3261  
 CO to 3340 20/ 3330-34 FU 100' oil  
 4 min. FU 300' oil 25 min.  
 S/ 12 bo 1 hr. DST 3307-40  
 open 1 hr. rec. 1200' mco 1020#  
 DST 3355-59 open 1/2 hr. rec. 1200' sw  
 1150# 5 1/2" @ 3358 CO to 3345

**OVER**

CO to 3345 20/ 3330-30 B/ 30 bo 8 hr.

Comp. 81 bopd 15% wtr.

R. G.

JUN 5 1956

County **Ellsworth** Elev. \_\_\_\_\_  
 Sec. **5** Twp. **16** Rge. **10W**  
 Company **Grant Oil**  
 Farm Name **Vacek** No. **1**

Co.

TOPS	DEPTH	LOG	DATUM
Anh.			
TP.			
H.			
Tr.			
Dg.			
BL.			
L.			
K.C.			
B.K.C.			
Ce.			
C.			
M.			
M.			
K.			
Mz.			
Ma.			
V.			
S.			
S.			
A.			
R.			
PE.			
G.			
T.D.			

Loc. in Sec. **SW NE NE**  
 Geol. \_\_\_\_\_  
 Contr. **Dutch George**  
 Pool **Stoltenberg**

Lse.

FIRST REPORT			
FEB 8 '56			

1st No.

Date Comm. **2-5-56**  
**8" @ 307/200 WOC**

Sec.

T.

R.

